

MAY 28 1997

OGEMAW COUNTY REMONUMENTATION

COMMISSION

LAND CORNER RECORDATION CERTIFICATE
Filing Requirement of Act 74, Mich. P.A. 1970

For corners in

Ogemaw (County)	Located In:	Corner Code #
1. Public Land Survey	T 22N R 2E	B - 1
	T R	
	T R	
	T R	
2. Property Controlling in Section	S T R	
	S T R	
3. Miscellaneous Property in Sec.	S T R	
	S T R	

4. Lot No. _____, Recorded Plat _____
5. Private Claims _____

I, Timothy L. Lapham, in a field survey on December, 19 86 do hereby state that under requirements of P.A. 74, Michigan P.A. of 1970, the corner points mentioned in lines 1 and 2 above were in conformance with regulations and rules therefore as required in the current manual of survey instructions of the United States Department of the Interior, Bureau of Land Management or by a decree of a Court of Law and /or that the corner points mentioned in lines 3, 4 and 5 above were in conformance with the rules of the Michigan Board of Land Surveyors or by a Decree of a Court of Law; established, re-established, monumented, recovered, found as expressed below.

NOTE: Not more than 2 corners, all in the same town and range, may be recorded on this certificate.

A. Description of original monument and accessories and/or subsequent restoration:

Not set by GLO
Unrecorded survey, Richardson, 872
No corner material
4 wits;


B. Description of corner evidence found and/or method applied in restoring or reestablishing corner:

No evidence of GLO corner found. Found 2" iron pipe at North side of Trall East & West at Centerline trail South. Distance West to B-13 T23N R2E and distance East to C-1 in accord with Richardson Survey. Accepted found corner as best evidence of the position of the original corner. See dossier for additional information.

C. Description of monument for corner and accessories established to perpetuate locating the position of the corner:

Set 5/8" X36" rod with 2-1/4" Aluminum cap marked "1986 27585"
From Which:
N40E 2.72' 8" Maple
S38W 32.38' 5" Poplar
S18W 30.48' 15" Oak
S71W 47.19' 12" Oak
Monument Located 10' North of centerline trail East-West and in Centerline Trail South

APPROVED BY
PEER REVIEW
12-18-96 TLL
DATE P.A. 345 of 1990

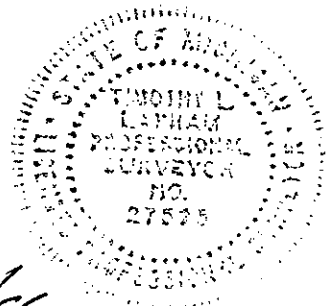

Signed by [Signature]
Surveyor's Michigan License No. 27585

Date 12/27/96

	A	B	C	D	E	F	G	H	I	J	K	L
1		•										
2		6		5		4		3		2		1
3												
4		7		8		9		10		11		12
5												
6		10		17		16		15		14		13
7												
8		19		20		21		22		23		24
9												
10		30		29		28		27		26		25
11												
12		31		32		33		34		35		36
13												