

MAY 28 1997

LAND CORNER RECORDATION CERTIFICATE  
Filing Requirement of Act 74, Mich. P.A. 1970

For corners in COMMISSION

Ogemaw (County)	Located In:	Corner Code #
1. Public Land Survey	T 22N R 2E	B - 5
	T R	
	T R	
	T R	
2. Property Controlling in Section	S T R	
	S T R	
3. Miscellaneous Property in Sec.	S T R	
	S T R	

STATE OF MICHIGAN  
OGEMAW COUNTY  
RECORDED  
30 DEC 96 4:31 P.M.  
WANDA MUZIK  
REGISTER OF DEEDS  
Register of Deeds Stamp & File Number

4. Lot No. \_\_\_\_\_, Recorded Plat \_\_\_\_\_  
5. Private Claims \_\_\_\_\_

I, Timothy L. Lapham, in a field survey on December, 19 96 do hereby state that under requirements of P.A. 74, Michigan P.A. of 1970, the corner points mentioned in lines 1 and 2 above were in conformance with regulations and rules therefore as required in the current manual of survey instructions of the United States Department of the Interior, Bureau of Land Management or by a decree of a Court of Law and for that the corner points mentioned in lines 3, 4 and 5 above were in conformance with the rules of the Michigan Board of Land Surveyors or by a Decree of a Court of Law; established, re-established, monumented, recovered, found as expressed below:

	A	B	C	D	E	F	G	H	I	J	K	L	M
1													
2	6	5	4	3	2	1							
3													
4	7	8	9	10	11	12							
5													
6	18	17	16	15	14	13							
7													
8	19	20	21	22	23	24							
9													
10	30	29	28	27	26	25							
11													
12	31	32	33	34	35	36							
13													

NOTE: Not more than 2 corners, all in the same town and range, may be recorded on this certificate.

A. Description of original monument and accessories and/or subsequent restoration:

GLO, Hall, 1845	Survey Cavanagh, 5/77 (Rec L2, P278)
1 1/2" Cedar for post	Found 1/2" bar
Survey, Cavanagh, 8/71 (Rec L1, P36)	Wits same as survey L1, P36
No material	LCRC, Lapham 11/88 (Rec L2, P73)
3 wits;	Found 1/2" bar
Survey, Cavanagh, 5/72 (Rec L2, P306)	3 Wits;
Found 1/2" bar	LCRC, Lapham, 3/93 (Rec L2, P201)
Wits same as L1, P36	Rail road spike
LCRC, Cavanagh, 4/73 (Rec L1, P37)	4 wits;
Set 1/2" bar	
Wits same as L1 P36	


B. Description of corner evidence found and/or method applied in restoring or reestablishing corner:

No evidence of GLO corner found. Found 1/2" capped iron in accord with Lapham LCRCs. Accepted found corner as best evidence of the position of the original corner. See dossier for additional information.

APPROVED BY  
PEER REVIEW  
12-18-96  
DATE P.A. 345 of 1990

C. Description of monument for corner and accessories established to perpetuate locating the position of the corner:

Set 5/8"x36" rerod with 2-1/4" Aluminum cap marked "1996 27595"  
in Monument Box  
From Which:  
N84E 86.39' 12" Cedar  
S24E 59.30' 10" Ash  
S38W 42.72 8" Ash  
N22W 52.42 6" N. Pine  
Monument located 10' South of Centerline Maes Road East-West and 35' East of Centerline Drive North.

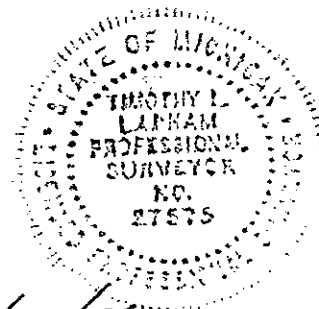

Signed by [Signature]  
Surveyor's Michigan License No. 27595

Date 12/27/96