

MAY 28 1997

LAND CORNER RECORDATION CERTIFICATE  
Filing Requirement of Act 74, Mich. P.A. 1970

For corners in COMMISSION

Ogemaw (County)	Located in:	Corner Code #
1. Public Land Survey	T 22N R 2E	C - 3
	T R	
	T R	
	T R	
2. Property Controlling in Section	S T R	
	S T R	
3. Miscellaneous Property in Sec.	S T R	
	S T R	

STATE OF MICHIGAN  
OGEMAW COUNTY  
RECORDED  
30 DEC 96 4:29 P.M.  
WANDA MUZIK  
REGISTER OF DEEDS

Register of Deeds Stamp & File Number

4. Lot No. \_\_\_\_\_, Recorded Plat \_\_\_\_\_  
5. Private Claims \_\_\_\_\_

I, Timothy L. Lapham, in a field survey on December, 19 96 do hereby state that under requirements of P.A. 74, Michigan P.A. of 1970, the corner points mentioned in lines 1 and 2 above were in conformance with regulations and rules therefore as required in the current manual of survey instructions of the United States Department of the Interior, Bureau of Land Management or by a decree of a Court of Law and/or that the corner points mentioned in lines 3, 4 and 5 above were in conformance with the rules of the Michigan Board of Land Surveyors or by a Decree of a Court of Law; established, re-established, monumented, recovered, found as expressed below:

NOTE: Not more than 2 corners, all in the same town and range, may be recorded on this certificate.

	A	B	C	D	E	F	G	H	I	J	K	L	M
1													
2	6		5		4		3		2		1		
3			●										
4	7		8		9		10		11		12		
5													
6	18		17		16		15		14		13		
7													
8	19		20		21		22		23		24		
9													
10	30		29		28		27		26		25		
11													
12	31		32		33		34		35		36		
13													

A. Description of original monument and accessories and/or subsequent restoration:

GLO, Hall 1845	No Wits;
Set post	LCRC, Lapham, 1/83 (Rec L2, P189)
Hemlock 16 S67W 8	Found capped iron
do 8 N48W 7	4 wits;
Unrecorded Survey, Richardson 8/72	Survey, Lapham, 7/94 (Rec L5, P452)
No corner material or Wits;	Same as LCRC L2, P189
LCRC, Cavanagh, 4/73 (Rec L1, P37)	
Set 1/2" X 18" Bar & Hub	
3 Wits;	
Survey Higgins, 10/82 (Rec L3, P533)	
Found 1/2" Bar	


B. Description of corner evidence found and/or method applied in restoring or reestablishing corner:

No evidence of GLO corner found. Found 1/2" iron in monument box in centerline of North-South road at Road East in accord with Lapham LCRC. Accepted found corner as best evidence of the position of the original corner. See dossier for additional information.

APPROVED BY  
PEER REVIEW  
12-18-96 JW  
DATE P.A. 345 of 1990

C. Description of monument for corner and accessories established to perpetuate locating the position of the corner:

Set 5/8" X 36" rerod with 2-1/4" Aluminum cap marked "1896 27585"  
From Which:  
N57E 73.79' Nail and washer in utility Pole  
S62E 101.18' 14" W. Pine  
S60W 55.17' PK nail in utility pole  
N61W 80.77' 12" Norway pine  
Monument located 2' West of centerline of Fairview road.

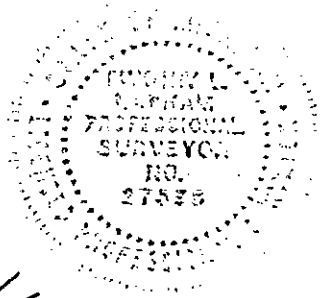

Signed by [Signature]  
Surveyor's Michigan License No. 27585

Date 12/27/96