

SURVEY &
REMONUMENTATION

MAY 28 1997

OGEMAW COUNTY REMONUMENTATION

LIBER 3 PAGE 83

COMMISSION

LAND CORNER RECORDATION CERTIFICATE
Filing Requirement of Act 74, Mich. P.A. 1970

For corners in

Ogemaw (County)	Located In:	Corner Code #
1. Public Land Survey	T 22N R 2E	C - 4
	T R	
	T R	
	T R	
2. Property Controlling in Section	S T R	
	S T R	
3. Miscellaneous Property in Sec.	S T R	
	S T R	

STATE OF MICHIGAN
OGEMAW COUNTY
RECORDED

30 DEC 96 4:30 P.M.

WANDA MUZIK
REGISTER OF DEEDS

Register of Deeds Stamp & File Number

4. Lot No. _____, Recorded Plat _____
5. Private Claims _____

I, Timothy L. Lapham, in a field survey on December, 1996 do hereby state that under requirements of P.A. 74, Michigan P.A. of 1970, the corner points mentioned in lines 1 and 2 above were in conformance with regulations and rules therefore as required in the current manual of survey instructions of the United States Department of the Interior, Bureau of Land Management or by a decree of a Court of Law and /or that the corner points mentioned in lines 3, 4 and 5 above were in conformance with the rules of the Michigan Board of Land Surveyors or by a Decree of a Court of Law; established, re-established, monumented, recovered, found as expressed below:

NOTE: Not more than 2 corners, all in the same town and range, may be recorded on this certificate.


	A	B	C	D	E	F	G	H	I	J	K	L
1												
2	6		5		4		3		2		1	
3												
4	7	●	8		9		10		11		12	
5												
6	18		17		16		15		14		13	
7												
8	19		20		21		22		23		24	
9												
10	30		29		28		27		26		25	
11												
12	31		32		33		34		35		36	
13												

A. Description of original monument and accessories and/or subsequent restoration:

- GLO, Hall 1845 Survey, Ledy, 8/90 (Rec L4, P436)
36" White pine for post Fnd. 3/8" rod
- Survey, Cavanagh, 4/73 (Rec L1, P207) 4 wits;
- Set 1/2" X 18" steel bar Survey, King, 3/82 (Rec L5, P161)
3 wits; No corner material or wits;
- LCRC, Cavanagh, 4/73 (Rec L1, P37) Survey, Lapham, 10/85 (Rec L6, P105)
Same as survey L1, P207 Fnd. capped iron
- Survey, Cavanagh, 7/75 (Rec L1, P591) No Wits;
- No material or wits;
- Survey, Higgins, 6/78 (Rec L3, P107)
- No Material or wits;


B. Description of corner evidence found and/or method applied in restoring or reestablishing corner:

No evidence of GLO corner found. Found 1/2" iron in accord with surveys by Cavanagh and Ledy and Cavanagh LCRC. Distance South in accord with King and Lapham surveys. Accepted found corner as best evidence of the position of the original corner. See dossier for additional information.

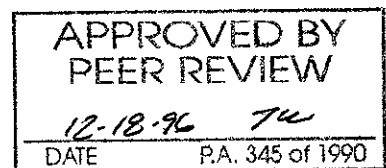

C. Description of monument for corner and accessories established to perpetuate locating the position of the corner:

Set 5/8" X 36" rerod with 2-1/4" Aluminum cap marked "1996 27595"
From Which:
North 13.0' Centerline Driveway
N78E 13.43' 12" W. Pine
S04W 62.87' 24" Oak
West 35.0' Centerline Fairview road

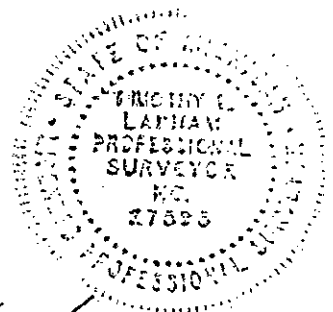

Signed by [Signature]
Surveyor's Michigan License No. 27595

Date 12/27/96