

MAY 28 1997

LAND CORNER RECORDATION CERTIFICATE
Filing Requirement of Act 74, Mich. P.A. 1970

COMMISSION

For corners in

Ogemaw (County)	Located In:	Corner Code #
1. Public Land Survey	T <u>22N</u> R <u>2E</u>	<u>C - 6</u>
	T <u> </u> R <u> </u>	<u> </u>
	T <u> </u> R <u> </u>	<u> </u>
	T <u> </u> R <u> </u>	<u> </u>
2. Property Controlling in Section	S <u> </u> T <u> </u> R <u> </u>	<u> </u>
	S <u> </u> T <u> </u> R <u> </u>	<u> </u>
3. Miscellaneous Property in Sec.	S <u> </u> T <u> </u> R <u> </u>	<u> </u>
	S <u> </u> T <u> </u> R <u> </u>	<u> </u>

STATE OF MICHIGAN
OGEMAW COUNTY
RECORDED

30 DEC 96 4:30 P.M.

WANDA MUZIK
REGISTER OF DEEDS
Register of Deeds Stamp & File Number

4. Lot No. _____, Recorded Plat _____
5. Private Claims _____

I, Timothy L Lapham, in a field survey on December, 19 96 do hereby state that under requirements of P.A. 74, Michigan P.A. of 1970, the corner points mentioned in lines 1 and 2 above were in conformance with regulations and rules therefore as required in the current manual of survey instructions of the United States Department of the Interior, Bureau of Land Management or by a decree of a Court of Law and /or that the corner points mentioned in lines 3, 4 and 5 above were in conformance with the rules of the Michigan Board of Land Surveyors or by a Decree of a Court of Law; established, re-established, monumented, recovered, found as expressed below:

NOTE: Not more than 2 corners, all in the same town and range, may be recorded on this certificate.

1	A	B	C	D	E	F	G	H	I	J	K	L
2		6		5		4		3		2		1
3												
4		7		8		9		10		11		12
5												
6		18		17		16		15		14		13
7												
8		19		20		21		22		23		24
9												
10		30		29		28		27		26		25
11												
12		31		32		33		34		35		36
13												

A. Description of original monument and accessories and/or subsequent restoration:

GLO, Hall 1845
20" Hemlock for Post
LCRC, Higgins, 2/80 (Rec L1, P262)
Found nail in centerline of road & E-W fences
4 wits;


B. Description of corner evidence found and/or method applied in restoring or reestablishing corner:

No evidence of GLO corner found. Found 1/2" capped iron #27595. Higgins witnesses apparently destroyed during road construction. Accepted found corner as best evidence of the position of the original corner. See dossier for additional information.

APPROVED BY
PEER REVIEW
12-18-96 *JL*
DATE P.A. 345 of 1990

C. Description of monument for corner and accessories established to perpetuate locating the position of the corner:

Set 5/8" X36" rerod with 2-1/4" Aluminum cap marked "1996 27595"
From Which:
N15E 76.75' 10" Oak
S40E 41.53' 5" Elm
S08E 73.18' 4" Elm in cluster
N89W 17.68' Monument box

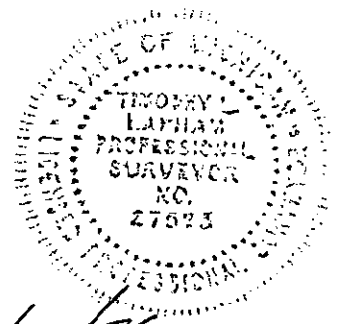

Signed by *Timothy Lapham*
Surveyor's Michigan License No. 27595

Date 12/27/96