

MAY 28 1997

LAND CORNER RECORDATION CERTIFICATE  
Filing Requirement of Act 74, Mich. P.A. 1970

For corners in COMMISSION

Ogemaw (County)	Located In:	Corner Code #
1. Public Land Survey	T 22N R 2E	C - 7
	T R	
	T R	
	T R	
2. Property Controlling in Section	S T R	
	S T R	
3. Miscellaneous Property in Sec.	S T R	
	S T R	

STATE OF MICHIGAN  
OGEMAW COUNTY  
RECORDED

30 DEC 96 4:30 P.M.

WANDA NUZIK  
REGISTER OF DEEDS

Register of Deeds Stamp & File Number

4. Lot No. \_\_\_\_\_, Recorded Plat \_\_\_\_\_  
5. Private Claims \_\_\_\_\_

I, Timothy L. Lapham, in a field survey on December, 19 96 do hereby state that under requirements of P.A. 74, Michigan P.A. of 1970, the corner points mentioned in lines 1 and 2 above were in conformance with regulations and rules therefore as required in the current manual of survey instructions of the United States Department of the Interior, Bureau of Land Management or by a decree of a Court of Law and for that the corner points mentioned in lines 3, 4 and 5 above were in conformance with the rules of the Michigan Board of Land Surveyors or by a Decree of a Court of Law; established, re-established, monumented, recovered, found as expressed below:

NOTE: Not more than 2 corners, all in the same town and range, may be recorded on this certificate.

1	A	B	C	D	E	F	G	H	I	J	K	L
2	6		5		4		3		2		1	
3												
4	7		8		9		10		11		12	
5												
6	18		17		16		15		14		13	
7												
8	19		20		21		22		23		24	
9												
10	30		29		28		27		26		25	
11												
12	31		32		33		34		35		36	
13												

A. Description of original monument and accessories and/or subsequent restoration:

GLO, Hall, 1845  
Set Post  
Beech 12 S22W 23  
do 8 N3W 31  
LCRC, Courtright, 1/73 (Rec L1, P71)  
Fd. nail  
3 wits;


B. Description of corner evidence found and/or method applied in restoring or reestablishing corner:

No evidence of GLO corner found. Found 1/2" iron in monument box in centerline road North-South and Centerline Road East. Courtright witnesses apparently destroyed during road construction. Accepted found corner as best evidence of the position of the original corner. See dossier for additional information.

APPROVED BY  
PEER REVIEW  
12-18-96 JL  
DATE P.A. 345 of 1990

C. Description of monument for corner and accessories established to perpetuate locating the position of the corner:

Set 5/8"X36" rerod with 2-1/4" Aluminum cap marked "1996 27595"  
From Which:  
N49E 88.63' Flag Pole  
S39E 53.69' Utility Pole  
S47W 39.74' 8" Box Elder  
N33W 57.23' 8" Fir  
Monument located 5' North of centerline Finerty road and 1' West of centerline Fairview Road.

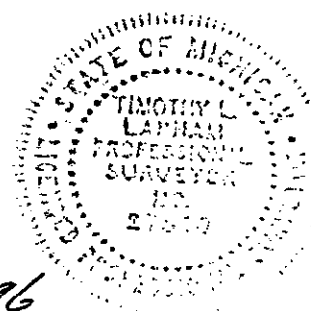

Signed by [Signature]  
Surveyor's Michigan License No. 27595

Date 12/27/96