

**SURVEY &  
REMONUMENTATION**

MAY 28 1997

OGEMAW COUNTY REMONUMENTATION

COMMISSION

**LAND CORNER RECORDATION CERTIFICATE**  
Filing Requirement of Act 74, Mich. P.A. 1970

For corners in

Ogemaw (County)	Located In:	Corner Code #
1. Public Land Survey	T <u>22N</u> R <u>2E</u>	C - 8
	T <u>    </u> R <u>    </u>	<u>    </u>
	T <u>    </u> R <u>    </u>	<u>    </u>
	T <u>    </u> R <u>    </u>	<u>    </u>
2. Property Controlling in Section	S <u>    </u> T <u>    </u> R <u>    </u>	<u>    </u>
	S <u>    </u> T <u>    </u> R <u>    </u>	<u>    </u>
3. Miscellaneous Property in Sec.	S <u>    </u> T <u>    </u> R <u>    </u>	<u>    </u>
	S <u>    </u> T <u>    </u> R <u>    </u>	<u>    </u>

STATE OF MICHIGAN  
OGEMAW COUNTY  
RECORDED

30 DEC 96 4:30 P.M.

WANDA MUZIK  
REGISTER OF DEEDS

Register of Deeds Stamp & File Number

4. Lot No. \_\_\_\_\_, Recorded Plat \_\_\_\_\_  
5. Private Claims \_\_\_\_\_

I, Timothy L. Lapham, in a field survey on December, 1996 do hereby state that under requirements of P.A. 74, Michigan P.A. of 1970, the corner points mentioned in lines 1 and 2 above were in conformance with regulations and rules therefore as required in the current manual of survey instructions of the United States Department of the Interior, Bureau of Land Management or by a decree of a Court of Law and /or that the corner points mentioned in lines 3, 4 and 5 above were in conformance with the rules of the Michigan Board of Land Surveyors or by a Decree of a Court of Law; established, re-established, monumented, recovered, found as expressed below:

NOTE: Not more than 2 corners, all in the same town and range, may be recorded on this certificate.

	A	B	C	D	E	F	G	H	I	J	K	L	M
1													
2	6		5		4		3		2		1		
3													
4	7		8		9		10		11		12		
5													
6	18		17		16		15		14		13		
7													
8	19		20		21		22		23		24		
9													
10	30		29		28		27		26		25		
11													
12	31		32		33		34		35		36		
13													

A. Description of original monument and accessories and/or subsequent restoration:

- GLO, Hall, 1845 Survey, Lapham, 11/92 (Rec L5, P254)
- 8" Aspen for post Found 1/2" iron
- LCRC, Courtright, 1/73 (Rec L1, P71) 3 Wits;
- Set PK nail
- 3 Wits;
- LCRC, Lapham, 7/86 (Rec L1, P349)
- PK Nail
- 3 wits;
- LCRC, Lapham, 7/89 (Rec L2, P88)
- Set 1/2"X18" Capped iron
- 4 wits;

B. Description of corner evidence found and/or method applied in restoring or reestablishing corner:

No evidence of GLO corner found. Found 1/2" iron in accord with recorded LCRCs and Lapham survey. Distance North matches Lapham survey. Accepted found corner as best evidence of the position of the original corner. See dossier for additional information.


APPROVED BY  
PEER REVIEW

12-18-96 TL

DATE P.A. 345 of 1990

C. Description of monument for corner and accessories established to perpetuate locating the position of the corner:

- Set 5/8"X36" rerod with 2-1/4" Aluminum cap marked "1996 27595"
- In Monument Box
- From Which:
- N50E 49.83' Utility Pole
- S44E 51.12' Sign post
- N88W 38.42' 8" Box Elder in Cluster
- N32W 79.21' Utility Pole

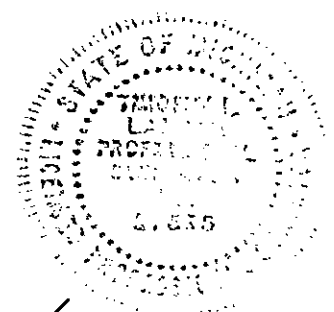

Signed by [Signature]  
Surveyor's Michigan License No. 27595

Date 12/27/96