

SURVEY & REMONUMENTATION

MAR 19 1998

OGEMAW COUNTY REMONUMENTATION

SECTION

LAND CORNER RECORDATION CERTIFICATE
Filing Requirement of Act 74, Mich. P.A. 1970

For corners in

Ogemaw (County)	Located In:	Corner Code #
1. Public Land Survey	T <u>22</u> N R <u>2E</u>	<u>C-13</u>
	T ___ R ___	_____
	T ___ R ___	_____
	T ___ R ___	_____
2. Property Controlling in Section	S ___ T ___ R ___	_____
	S ___ T ___ R ___	_____
3. Miscellaneous Property in Sec.	S ___ T ___ R ___	_____
	S ___ T ___ R ___	_____

LIBER 3 PAGE 128

STATE OF MICHIGAN
OGEMAW COUNTY
RECORDED

26 Dec 1997 2:50:48 PM

WANDA HUZIK
REGISTER OF DEEDS
Register of Deeds Stamp & File Number

4. Lot No. _____, Recorded Plat _____
5. Private Claims _____

I, Timothy L. Lapham, in a field survey on November 20 19 97 do hereby state that under requirements of P.A. 74, Michigan P.A. of 1970, the corner points mentioned in lines 1 and 2 above were in conformance with regulations and rules therefore as required in the current manual of survey instructions of the United States Department of the Interior, Bureau of Land Management or by a decree of a Court of Law and /or that the corner points mentioned in lines 3, 4 and 5 above were in conformance with the rules of the Michigan Board of Land Surveyors or by a Decree of a Court of Law, established, re-established, monumented, recovered, found as expressed below:

NOTE: Not more than 2 corners, all in the same town and range, may be recorded on this certificate.

	A	B	C	D	E	F	G	H	I	J	K	L
1												
2	6		5		4		3		2		1	
3												
4	7		8		9		10		11		12	
5												
6	18		17		16		15		14		13	
7												
8	19		20		21		22		23		24	
9												
10	30		29		28		27		26		25	
11												
12	31		32		33		34		35		36	
13												

A. Description of original monument and accessories and/or subsequent restoration:

GLO, L. Clason 1837 set post
B. Ash 12" N41E 45 lk
Elm 12" N57W 40 lk
Closing corner falls 29 lk West of post

J. Richardson 1960 Survey
Corner shown, no witnesses

Cavanagh 1973 Surveys (L1-P283, L1-P337)
Corner shown, no witnesses

G. Henning 1954 Survey
Iron
Elm N67°20'W 31.5
Elm 14" N58 1/2E 36.7
Elm 20" S33 1/4E 49.5

Slattery (MDSH) 1965 cor. records, H/W plans
Found 1" pipe 3.0' below surface
raised w/ R.R. spike 2.5' W of center Cook Rd
S65E 88.99 22" Twin Elm
N80E 94.03 25" Elm
S85W 87.23 17" Elm
N89°49'36"W 19.02 NW cor Sec 5, 21N2E

R. Higgins 1977 Survey (L2, P329)
Corner shown, no witnesses

see back of sheet

B. Description of corner evidence found and/or method applied in restoring or reestablishing corner:

No evidence of GLO corner.
Found 1/2" boat spike in mon box in centerline Cook Rd. (BR I-75) and capped iron in concrete pavement 19.03 West
All witnesses prior to 1977 are gone, apparently due to construction of I-75.
Found, 1977 Martin, 3 witnesses Found, 1979 Quist, 3 witnesses.

Found corner accepted as best evidence of correct corner position.

C. Description of monument for corner and accessories established to perpetuate locating the position of the corner:


Set 5/8"x36" rerod with 3-1/4" Aluminum Ogemaw Remon cap marked "27595 1997" in Mon. Box
West 19.03 Aluminum Ogemaw Remon cap
S51E 43.2' centerline one-way traffic post
N38E 67.6 centerline one-way traffic post
North 35.0' expansion joint
West 0.1 centerline crack N-S
North 16.3+ (centerline of exit ramp)
S80E 62.2' SW corner of S leg wrong way sign
N65E 83.54 2nd post on N guard rail (spike in top)
S82E 74.35 1st post on S guard rail (spike in top)

Approved by Peer Review

11-2097 JW JBL
DATE INITIALS

Signed by Timothy L. Lapham
Surveyor's Michigan License No. 27595

Date 12/24/97

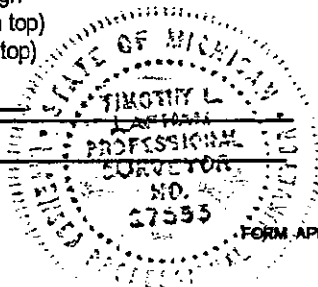

A. Continued C-13

J. Martin 1977 LCRC (L1, P187)
Mon box w/ 1" boat spike in centerline
joint concrete pavement N & S
S45E 40.40 center one-way traffic sign post
N45E 67.15 center one-way traffic sign post
North 35.07 expansion joint

R. Higgins 1978 Survey (L2, P445)
corner shown, no witnesses

J. Ray (Edmands Engineering)
1978 Survey (L3, P56-7)
same cor. & wits. as 1977 Martin LCRC

R. Higgins 1979 Survey (78114)
corner shown, no witnesses

P. Ciosek (Edmands Engineering)
1978 Survey (L3, P56-7)
same cor. & wits. as 1977 Martin LCRC

J. Quist 1979 LCRC (L1, P218)
Found Boat Spike in Monument Box
WEST 0.10 Centerline crack N & S
NORTH 15.9 Centerline crack E
EAST 62.80 SW Cor. of S. Leg of
"wrong way" sign

T. Lapham 1986 Survey (N860491)
same cor. & wits. as 1977 Martin LCRC

M. Myers 1988 Survey (L4, P256)
referenced LCRCs L1, P187 & 218

D. Ledy 1988 Survey (L4, P228)
references corner as 19.02 EAST of
C-1 T21N, R2E
no witnesses

T. Lapham 1990 Survey (358 deeds 949)
referenced LCRCs L1, P187 & 218

T. Lapham 1994 Survey (N943965)
referenced corner, no witnesses

T. Lapham 1996 Survey (N965203)
referenced corner, no witnesses

T. Lapham 1997 Survey (N975768b)
same cor. & wits. as 1977 Martin LCRC