

APR 08 1999

Ogemaw County Remonumentation

SECTION

LAND CORNER RECORDATION CERTIFICATE
Filing Requirement of Act 74, Mich. P.A. 1970

LIBER 3 PAGE 210

STATE OF MICHIGAN
OGEMAW COUNTY
RECORDED

23 DEC 1998 3:48:12 PM

WANDA KUZIK
REGISTER OF DEEDS

Register of Deeds Stamp & File Number

For corners in

_____ Ogemaw _____ (County)	Located in:	Corner Code #
1. Public Land Survey	T22N R02E	E-7
	T _____ R _____	_____
	T _____ R _____	_____
	T _____ R _____	_____
2. Property Controlling in Section	S _____ T _____ R _____	_____
	S _____ T _____ R _____	_____
3. Miscellaneous Property in Sec.	S _____ T _____ R _____	_____
	S _____ T _____ R _____	_____

4. Lot No. _____, Recorded Plat _____
5. Private Claims _____

I, Timothy L Lapham, in a field survey on December, 19 98, do hereby state that under requirements of P.A. 74, Michigan P.A. of 1970, the corner points mention in lines 1 and 2 above were in conformance with regulations and rules therefore as required in the current manual of survey instructions of the United States Department of the Interior, Bureau of Land Management or by a decree of a Court of Law and/or that the corner points mentioned in lines 3, 4 and 5 above were in conformance with the rules of the Michigan Board of Land Surveyors or by a Decree of a Court of Law; established, re-established, monumented, recovered, found as expressed below:

NOTE: Not more than 2 corners, all in the same town and range, may be recorded on this certificate

A. Description of original monument and accessories and/or subsequent restoration:

E-7: GLO 6/15/1846 B.F. Hall Hemlock 15" for corner, no witnesses

section break 12/1974 L. Cavanagh bar and cap, no witnesses

LCRC 1-158 11/20/1975 N. Caldwell found large spike reset 1/2" bar and cap
S65W 41.5 16" apple
N45E 34.6 power pole
centerline old road west and road N-S (1)

County road plans 1997 J.P. May 1/2" iron rod
S85E 39.90 1/2" Iron rod (2)
S52W 90.81 utility pole (3)
N42W 48.76 gas line marker post #66 (4)
N08W 112.87 fence post

B. Description of corner evidence found and/or method applied in restoring or reestablishing corner:

E-7: No evidence of GLO corner. Found 1/2" capped iron in centerline of new bituminous road north and south in gravel road centerline west in accord with witness (1). Found witnesses (2), (3) and (4), each measures record. Accepted found capped iron as best available evidence of correct position of corner.


C. Description of monument for corner and accessories established to perpetuate locating the position of the corner:

E-7: Set 5/8"x36" rod with aluminum Ogemaw county remon. cap

Witnesses:
S81W 97.29 spike in N face of NW trunk in clump of service berries (10" trunk)
S52W 46.80 capped iron
S85E 90.81 spike in SE face of power pole
N36W 48.76 centerline of gas pipeline marker #66

Approved by Peer Review

12/15/98 TL
DATE INITIALS

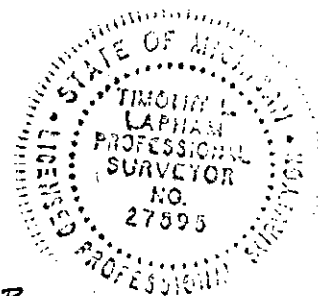

Signed by [Signature]
Surveyor's Michigan License No. 27595

Date 12/23/98