

APR 08 1999

SECTION

Ogemaw County Remonumentation

LAND CORNER RECORDATION CERTIFICATE
Filing Requirement of Act 74, Mich. P.A. 1970

LIBER 3 PAGE 208
STATE OF MICHIGAN
OGEMAW COUNTY
RECORDED

23 DEC 1998 3:47:46 PM

WANDA MUZIK
REGISTER OF DEEDS

Register of Deeds Stamp & File Number

For corners in

_____ Ogemaw _____ (County)	Located in:	Corner Code #
1. Public Land Survey	T22N R02E	E-9
	T _____ R _____	_____
	T _____ R _____	_____
	T _____ R _____	_____
2. Property Controlling in Section	S _____ T _____ R _____	_____
	S _____ T _____ R _____	_____
3. Miscellaneous Property in Sec.	S _____ T _____ R _____	_____
	S _____ T _____ R _____	_____

4. Lot No. _____, Recorded Plat _____
5. Private Claims _____

I, Timothy L Lapham, in a field survey on December, 19 98, do hereby state that under requirements of P.A. 74, Michigan P.A. of 1970, the corner points mention in lines 1 and 2 above were in conformance with regulations and rules therefore as required in the current manual of survey instructions of the United States Department of the Interior, Bureau of Land Management or by a decree of a Court of Law and/or that the corner points mentioned in lines 3, 4 and 5 above were in conformance with the rules of the Michigan Board of Land Surveyors or by a Decree of a Court of Law; established, re-established, monumented, recovered, found as expressed below:

NOTE: Not more than 2 corners, all in the same town and range, may be recorded on this certificate

A. Description of original monument and accessories and/or subsequent restoration:

- E-9: GLO 6/15/1846 B.F. Hall set post survey unrecorded 2/28/1975 L. Cavanagh corner same as LCRC 1-202
- Cedar 8" N17W 12 lk
- Cedar 10" S4E 10 lk
- section break 12/1974 L. Cavanagh PK nail 1' north of centerline survey unrecorded 2/28/1975 L. Cavanagh corner same as LCRC 1-202
- N30W 65.0 center top R/W marker (1) section break 1985+/- D. Ledy, PK nail
- S35E 70.96 steel CPP SSW 61.19 nail and tag in power pole (4)
- S30W 62.02 PP (tag) (2) NE 66.92 SW corner of base of telephone riser
- section break 1975 L.Cavanagh corner SE 70.70 face of 4" pipe fence corner material not specified, no witnesses
- LCRC 1-202 2/1975 L. Cavanagh found survey 3-547 4/10/1985 D. Ledy, PK nail no witnesses
- PK nail, 6.7 south of centerline road (3) survey 4-218 D. Ledy corner material not specified,

	A	B	C	D	E	F	G	H	I	J	K	L
1												
2	6		5		4		3		2		1	
3												
4	7		8		9		10		11		12	
5												
6	18		17		16		15		14		13	
7												
8	19		20		21		22		23		24	
9												
10	30		29		28		27		26		25	
11												
12	31		32		33		34		35		36	
13												

- 6.51 south of extension of centerline tangent (5)
- 0.70 north of centerline (6)
- County road plans J.P. May reset capped iron
- concrete R/W marker S26E 67.10 (7)
- power pole N41E 71.30 (8)
- Concrete R/W marker N23W 64.94 (9)

B. Description of corner evidence found and/or method applied in restoring or reestablishing corner:


E-9: No evidence of GLO corner or witnesses. Found capped iron 1.2' north of centerline of pavement, 11' +/- south of centerline PI of M-55, on centerline of road N-S. Found witnesses (1) and (9) leaning to west, measures 65.10. Witnesses (2) and (4) appear to be the same, measures 62.64 to new pole. Distances (3) and (5) match each other closely but do not appear to match the existing road centerline tangents, the reason for this discrepancy is unknown. Distance (6) is reasonably close to measured with the difference probably due to interpretation of centerline location. Witness (7) found and measures 67.03 to centerline top. Witness (8) found and measures 71.27. Accepted found capped iron as best evidence of correct corner position.

C. Description of monument for corner and accessories established to perpetuate locating the position of the corner:

- E-9: Set 5/8"x36" rerod with aluminum Ogemaw county remon. cap
- Witnesses:
- N W 65.10 centerline top of concrete right-of-way monument
- S W 62.64 spike in SE face of power pole
- S E 67.03 centerline top of concrete right-of-way monument
- N E 71.27 spike in SE face of power pole
- S E 75.26 spike in SW face of cut off utility pole

Approved by Peer Review

12/15/98 DATE INITIALS

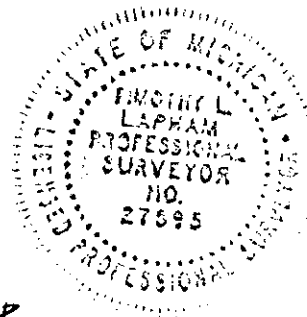

Signed by _____
Surveyor's Michigan License No. 27595

Date 12/23/98