

SURVEY & REMONUMENTATION

MAR 19 1998

OGEMAW COUNTY REMONUMENTATION

SECTION

LAND CORNER RECORDATION CERTIFICATE Filing Requirement of Act 74, Mich. P.A. 1970

LIBER **3** PAGE **137**
STATE OF MICHIGAN
OGEMAW COUNTY
RECORDED

26 Dec 1997 2:53:39 PM

WANDA MUZIK
REGISTER OF DEEDS

Register of Deeds Stamp & File Number

For corners in

<u>Ogemaw</u>	Located In:	Corner Code #	
(County)			
1. Public Land Survey	22N R 2E	E-13	
	T ___ R ___	___	___
	T ___ R ___	___	___
	T ___ R ___	___	___
2. Property Controlling in Section	S ___ T ___ R ___	___	___
	S ___ T ___ R ___	___	___
3. Miscellaneous Property in Sec.	S ___ T ___ R ___	___	___
	S ___ T ___ R ___	___	___

4. Lot No. _____, Recorded Plat _____
5. Private Claims _____

I, Timothy L. Lapham, in a field survey on November 20, 1997 do hereby state that under requirements of P.A. 74, Michigan P.A. of 1970, the corner points mentioned in lines 1 and 2 above were in conformance with regulations and rules therefore as required in the current manual of survey instructions of the United States Department of the Interior, Bureau of Land Management or by a decree of a Court of Law and /or that the corner points mentioned in lines 3, 4 and 5 above were in conformance with the rules of the Michigan Board of Land Surveyors or by a Decree of a Court of Law; established, re-established, monumented, recovered, found as expressed below:

NOTE: Not more than 2 corners, all in the same town and range, may be recorded on this certificate.

	A	B	C	D	E	F	G	H	I	J	K	L	M
1													
2		6		5		4		3		2		1	
3													
4		7		8		9		10		11		12	
5													
6		16		17		16		15		14		13	
7													
8		19		20		21		22		23		24	
9													
10		30		29		28		27		26		25	
11													
12		31		32		33		34		35		36	
13													

A. Description of original monument and accessories and/or subsequent restoration:
 GLO L. Clason 1837 Set post
 B. Ash 10" N65E 29 lk
 B. Ash 7" N5W 35 lk
 Closing corner 10 lk West of post
 G. Henning 1941 Survey
 Found iron in centerline roads N, E and W
 Twin Elm 10" N54 1/2W 112.5
 Corner Fence Post 8" S11W 31.5
 J. Richardson 1960 Survey
 1/2"x33" Steel Bar
 Telephone Pole N49E 45.93
 Power Pole N26W 69.15
 14" Twin Elm N54W 110.64
 Edmonds Engineering 1974 Surveys
 (L1-P461, L1-P500, L1-P503, L1-P511)
 Found 1/2" Iron
 N52E 47.75 Telephone Pole
 N18W 68.85 Power Pole

R. Higgins 1977 Survey (L2-P366)
References corner, No Witnesses
 D. Ledy 1983 Survey (L3-P459)
Same as Edmonds Eng 1974 witnesses
 D. Ledy 1985 Surveys (L4-P8, L4-P33)
Same as Edmonds Eng 1974 witnesses

B. Description of corner evidence found and/or method applied in restoring or reestablishing corner:
 No evidence of GLO corner

2 irons found in centerline of road E-W (paved). East iron in approximate centerline of gravel road North. Very old fence, mostly gone, approximately 5' West of East corner going South. No evidence of corner post remains. East iron used for corner. 1941 position matches current road location with witnesses gone. 1960 Richardson witness #1 gone but telephone pedestal in approximate position for witness. 1989 and 1992 Lapham witnesses in place.


Accepted found iron as best evidence of correct corner position.

C. Description of monument for corner and accessories established to perpetuate locating the position of the corner:

Set 5/8"x36" rered with 3-1/4" Aluminum Ogemaw Remon cap marked "27595 1997" From Which:
 Centerline road N, E and W
 N55E 47.3 Top centerline Telephone Pedestal (pole gone)
 West 6.60 Aluminum Ogemaw Remon cap
 N49W 49.0 Center of Telephone Pedestal top
 N64E 59.42 Power Pole
 S50E 59.38 Anchor Pole
 S12W 33.83 1/2" capped iron (Lapham)

Approved by Peer Review
11-26-97 TL LL
 DATE INITIALS

Signed by [Signature]
 Surveyor's Michigan License No. 27595

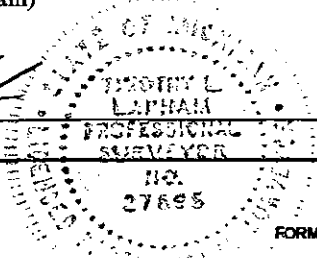

Date 12/24/97