

SURVEY & REMONUMENTATION

MAR 19 1998

OGEMAW COUNTY REMONUMENTATION

SECTION

LAND CORNER RECORDATION CERTIFICATE Filing Requirement of Act 74, Mich. P.A. 1970

For corners in

<u>Ogemaw</u> (County)	Located In:	Corner Code #
1. Public Land Survey	T <u>22N</u> R <u>2E</u>	<u>G-13</u>
	T <u> </u> R <u> </u>	<u> </u>
	T <u> </u> R <u> </u>	<u> </u>
	T <u> </u> R <u> </u>	<u> </u>
2. Property Controlling in Section	S <u> </u> T <u> </u> R <u> </u>	<u> </u>
	S <u> </u> T <u> </u> R <u> </u>	<u> </u>
3. Miscellaneous Property in Sec.	S <u> </u> T <u> </u> R <u> </u>	<u> </u>
	S <u> </u> T <u> </u> R <u> </u>	<u> </u>

LIBER 3 PAGE 139
STATE OF MICHIGAN
OGEMAW COUNTY
RECORDED

26 Dec 1997 2:54:32 PM

WANDA MUZIK
REGISTER OF DEEDS

Register of Deeds Stamp & File Number

4. Lot No. _____, Recorded Plat _____
5. Private Claims _____

I, Timothy L. Lapham, in a field survey on November 20 19 97 do hereby state that under requirements of P.A. 74, Michigan P.A. of 1970, the corner points mentioned in lines 1 and 2 above were in conformance with regulations and rules therefore as required in the current manual of survey instructions of the United States Department of the Interior, Bureau of Land Management or by a decree of a Court of Law and/or that the corner points mentioned in lines 3, 4 and 5 above were in conformance with the rules of the Michigan Board of Land Surveyors or by a Decree of a Court of Law; established, re-established, monumented, recovered, found as expressed below:

NOTE: Not more than 2 corners, all in the same town and range, may be recorded on this certificate.

	A	B	C	D	E	F	G	H	I	J	K	L	M
1													
2		6		5		4		3		2		1	
3													
4		7		8		9		10		11		12	
5													
6		18		17		16		15		14		13	
7													
8		19		20		21		22		23		24	
9													
10		30		29		28		27		26		25	
11													
12		31		32		33		34		35		36	
13													

A. Description of original monument and accessories and/or subsequent restoration:

GLO L. Clason 1837 set post S. Maple 9" N37E 15 lk W. Pine 24" N33W 61 lk Closing corner 19 lk West of G-13	Ledy 1989 Survey (L5, P39) Drawing calls for G1/G13 actually E1/E13	Ledy 1992 Survey (L6, P254-60) Same as LCRC, L3, P7
Cavanagh 1974 Survey (Victor River Estates) Set 1/2"x18" steel bar No witnesses	Ledy 1992 LCRC (L3, P7) Found 1/2" rod with cap ESE 83.45 6" Oak SW 42.32 4" Oak N'y 30.50 Power Pole NE 51.92 12" Pine W 12.3 G-1	T. Lapham 1993 Survey (N933367) Found capped iron N20E 30.50 Utility Pole N45E 51.96 14" R. Pine S40W 42.32 4" Oak In centerline road

B. Description of corner evidence found and/or method applied in restoring or reestablishing corner:

No evidence of GLO corner

Found two 1/2" rerods in centerline road 12.28' apart GLO calls for 12.55' between corners. East corner has been accepted in recent times as G-13. 1992 Ledy and 1993 Lapham witnesses found.

Accepted found iron as best evidence of correct corner position.

C. Description of monument for corner and accessories established to perpetuate locating the position of the corner:


Set 5/8"x36" rerod with 3-1/4" Aluminum Ogemaw Remon cap marked "27595 1997" From Which:

S57E 83.48 10" Oak
S30W 42.31 4" Oak
N10E 30.50 Power Pole
N42E 51.38 Twin 14" pine (spike S face)
West 12.48 3-1/4" Aluminum Ogemaw Remon cap
N07E 33.00 4" diam concrete monument w/ Ledy cap on brushed line corner in centerline pavement E-W

Approved by Peer Review

11-20-97 *WJ* *JSL*
DATE INITIALS

Signed by *Timothy L. Lapham*
Surveyor's Michigan License No. 27595

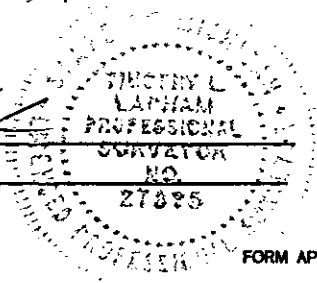

Date 12/24/97