

APR 08 1999

SECTION

Ogemaw County Remonumentation

LAND CORNER RECORDATION CERTIFICATE  
Filing Requirement of Act 74, Mich. P.A. 1970

LIBER 3 PAGE 214

For corners in

<u>Ogemaw</u> (County)	Located in:	Corner Code #
1. Public Land Survey	T22N R02E	J-5
	T R	
	T R	
	T R	
2. Property Controlling in Section	S T R	
	S T R	
3. Miscellaneous Property in Sec.	S T R	
	S T R	

STATE OF MICHIGAN  
OGEMAW COUNTY  
RECORDED

23 DEC 1998 3:49:07 PM

WANDA MUZIK  
REGISTER OF DEEDS

Register of Deeds Stamp & File Number

4. Lot No. \_\_\_\_\_, Recorded Plat \_\_\_\_\_  
5. Private Claims \_\_\_\_\_

I, Timothy L Lapham, in a field survey on December, 19 98, do hereby state that under requirements of P.A. 74, Michigan P.A. of 1970, the corner points mention in lines 1 and 2 above were in conformance with regulations and rules therefore as required in the current manual of survey instructions of the United States Department of the Interior, Bureau of Land Management or by a decree of a Court of Law and/or that the corner points mentioned in lines 3, 4 and 5 above were in conformance with the rules of the Michigan Board of Land Surveyors or by a Decree of a Court of Law; established, re-established, monumented, recovered, found as expressed below:

NOTE: Not more than 2 corners, all in the same town and range, may be recorded on this certificate

A	B	C	D	E	F	G	H	I	J	K	L	M
1												
2	6		5		4		3		2		1	
3												
4	7		8		9		10		11		12	
5												
6	18		17		16		15		14		13	
7												
8	19		20		21		22		23		24	
9												
10	30		29		28		27		26		25	
11												
12	31		32		33		34		35		36	
13												

A. Description of original monument and accessories and/or subsequent restoration:


J-5: GLO 6/13/1846 B.F. Hall set post Hemlock 10" S76E 17 lk Hemlock 10" S73W 7 lk	survey unrec 4/12/1976 N. Caldwell cor and wit same as LCRC 1-156, distance to I-5= 2601.17, distance to K-5= 2616.52	survey unrec 5/12/1982 R, Higgins cor matl not spec, no wits	West 30.62 nail in 22" cedar East 27.91 nail in post SSE 83.95 power pole (6)
Survey 1-379 2/7/1974 L. McGinnis 8" spk 4' E of cl rd 2' north of west fence line (1) W 30.35 face 14" cedar NW 45.5 face 14" cedar	survey unrec 5/28/1976 R. Higgins fd 1/2" bar fence line east and west (3) 14" cedar WEST 30.35 14" cedar NW 45.4	survey 3-475 7/2/1984 D. Ledy 1/2" rod with cap W 30.62 nail in 22" cedar E 27.91 nail in post S25E PP 83.95 (4)	survey unrec 10/6/1997 T. Lapham fd 1/2" CI 7' west to centerline road S84E 32.53 capped iron (7) S17E 83.97 utility pole (8) N85W 33.61 capped iron N44W 115.50 NE corner of shed (9)
sec 11 break 2/1974 Wade Trim 8" spk, wits same as 1-379	survey unrec 3/3/1977 R, Higgins fd 1/2" bar and cap, no wits	survey unrec 10/19/1984 R, Higgins iron, no wits	
LCRC 1-156 11/20/1975 N. Caldwell fd 10" spk reset 1/2" bar 4' east of centerline road south 2' fence line west (2) west 30.35 14" cedar NW 45.4 14" cedar	survey 2-240 3/7/1977 R. Higgins fd 1/2" bar and cap, no wits	survey 4-374 12/12/1990 D. Ledy found 1/2" rod W 30.35 to nail in 14" cedar E 27.91 to nail in post SSE 83.95 PP (5) NW 45.4 spike in 14" cedar	
	survey unrec 12/20/1977 R, Higgins fd 1/2" bar and cap, no wits	Wit sheet 1990's Ledy Engineering 1/2" rod with cap	

B. Description of corner evidence found and/or method applied in restoring or reestablishing corner:  
J-5: No evidence of GLO corner. All witnesses gone except: old fence line west and remains of line east approximately as called for in witness (1), (2) and (3); power pole witnesses (4) through (6) and (8) measured 83.97; shed (8), measured 115.50; and capped iron (7), measured 32.53. Accepted found iron as best evidence of correct position of corner.

C. Description of monument for corner and accessories established to perpetuate locating the position of the corner:

J-5: set 5/8"x36" rered with aluminum Ogemaw county remon. cap  
witnesses:  
S14E 83.97 spike in NE face of power pole  
S87E 32.53 1/2" rered  
N38W 115.50 NE corner of shed  
N48W 44.54 spike in NE face of 10" cedar  
west 1.8'+/- centerline of road north & south

Approved by Peer Review  
12/15/98  
DATE INITIALS

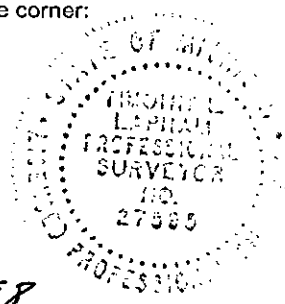

Signed by [Signature]  
Surveyor's Michigan License No. 27595

Date 12/23/1998