

APR 08 1999

Ogemaw County Remonumentation

SECTION

LAND CORNER RECORDATION CERTIFICATE
Filing Requirement of Act 74, Mich. P.A. 1970

For corners in

_____ Ogemaw _____ (County)	Located in:	Corner Code #
1. Public Land Survey	T22N R02E	J-6
	T _____ R _____	_____
	T _____ R _____	_____
	T _____ R _____	_____
2. Property Controlling in Section	S _____ T _____ R _____	_____
	S _____ T _____ R _____	_____
3. Miscellaneous Property in Sec.	S _____ T _____ R _____	_____
	S _____ T _____ R _____	_____

LIBER 3 PAGE 215
STATE OF MICHIGAN
OGEMAW COUNTY
RECORDED

23 DEC 1998 3:49:20 PM

WANDA MUZIK
REGISTER OF DEEDS

Register of Deeds Stamp & File Number

4. Lot No. _____, Recorded Plat _____
5. Private Claims _____

I, Timothy L Lapham, in a field survey on December, 1998, do hereby state that under requirements of P.A. 74, Michigan P.A. of 1970, the corner points mention in lines 1 and 2 above were in conformance with regulations and rules therefore as required in the current manual of survey instructions of the United States Department of the Interior, Bureau of Land Management or by a decree of a Court of Law and/or that the corner points mentioned in lines 3, 4 and 5 above were in conformance with the rules of the Michigan Board of Land Surveyors or by a Decree of a Court of Law; established, re-established, monumented, recovered, found as expressed below:

A	B	C	D	E	F	G	H	I	J	K	L
1											
2	6		5		4		3		2		1
3											
4	7		8		9		10		11		12
5											
6	10		17		16		15		14		13
7											
8	19		20		21		22		23		24
9											
10	30		29		28		27		26		25
11											
12	31		32		33		34		35		36
13											

NOTE: Not more than 2 corners, all in the same town and range, may be recorded on this certificate

A. Description of original monument and accessories and/or subsequent restoration:

J-6: not set in GLO survey plat of Birchcrest Shore 2-35 5/19/1955 H.C. Hook, cor matl not spec, no wits survey unrecorded 2/7/1984 R, Higgins found 1" steel rod, no witnesses survey unrecorded 10/14/1987 T. Lapham corner material not spec, no wits Distance to J-7= 2612.15 (1) survey unrecorded 8/31/1987 T. Lapham found capped iron, no wits Distance to J-7= 2612.17 (2)	witness sheet 1990+/- Ledy Eng capped iron West 33.12 power pole (3) N35E 72.30 4" Aspen (4) S38W 75.13 1/2" iron (5) S40E 49.64 1/2" iron (6) survey unrec 8/16/1991 T. Lapham fd 1/2" capped iron, wits same as Ledy Eng wit sheet survey unrecorded 9/20/1991 D. Ledy corner and witnesses same as Ledy Engineering witness sheet LCRC 2-188 8/16/1992 T. Lapham corner and witnesses same as Ledy Engineering witness sheet survey unrecorded 8/20/1992 D. Ledy	corner and witnesses same as Ledy Engineering witness sheet survey 5-432 3/31/1994 T. Lapham corner and witnesses same as Ledy Engineering witness sheet survey 6-206 11/8/1995 T. Lapham corner and witnesses same as Ledy Engineering witness sheet survey 6-207 11/26/1996 T. Lapham corner and witnesses same as Ledy Engineering witness sheet survey unrecorded 10/6/1997 T. Lapham corner and witnesses same as Ledy Engineering witness sheet
---	---	---

B. Description of corner evidence found and/or method applied in restoring or reestablishing corner:


J-6: Found 1/2" rod in centerline bituminous road at fence line west. Unable to determine if plat of Birchcrest Shore matches found iron due to gross errors in plat. Distances (1) and (2) match measured. Found witness (3), measured 33.20. Found witness (4), measured 72.44 to 6" Aspen. Found witness (5), measured 75.25. Found witness (6), measured 49.53. Found iron is 1.5'+/- east of north-south 1/4 line and is 8'+/- south of line from E 1/4 corner at mean bearing of north and south lines of section. A fence west from iron and apparent north line of Birchcrest Shore is on extension of line from E 1/4 corner to found iron. Due to the large number of surveys utilizing the found iron and the large deflection on the north section line it was decided to accept the found iron as an existing established corner located within acceptable tolerances of the theoretical center of section using the procedures acceptable at the time of establishment.

C. Description of monument for corner and accessories established to perpetuate locating the position of the corner:

J-6: Set 5/8"x36" rod with aluminum Ogemaw county remon. cap
witnesses:
West 33.20 spike on S face of power pole
N35E 72.44 spike on NW face of 6" Aspen
S38W 75.25 1/2" iron
S40E 49.53 1/2" iron
N25W 116.84 spike in SW face of power pole

Approved by Peer Review

12/15/98 _____
DATE INITIALS

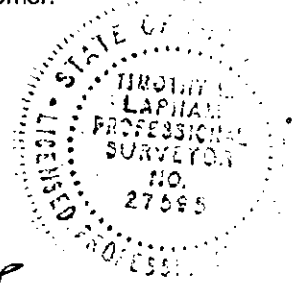

Signed by [Signature]
Surveyor's Michigan License No. 27595

Date 12/23/1998