

**SURVEY &
REMONUMENTATION**

MAR 19 1998

OGEMAW COUNTY REMONUMENTATION

**LAND CORNER RECORDATION CERTIFICATE
Filing Requirement of Act 74, Mich. P.A. 1970**

SECTION

For corners in

<u>Ogemaw</u> (County)	Located in:	Corner Code #
	T <u>22N</u> R <u>2E</u>	<u>J - 13</u>
1. Public Land Survey	T _____ R _____	_____
	T _____ R _____	_____
	T _____ R _____	_____
	T _____ R _____	_____
2. Property Controlling in Section	S _____ T _____ R _____	_____
	S _____ T _____ R _____	_____
3. Miscellaneous Property in Sec.	S _____ T _____ R _____	_____
	S _____ T _____ R _____	_____

LIBER 3 PAGE 153

STATE OF MICHIGAN
OGEMAW COUNTY
RECORDED

26 Dec 1997 2:59:26 PM

WANDA MUZIK
REGISTER OF DEEDS

Register of Deeds Stamp & File Number

4. Lot No. _____, Recorded Plat _____
5. Private Claims _____

1	A	B	C	D	E	F	G	H	I	J	K	L	M
2		6		5		4		3		2		1	
3													
4		7		8		9		10		11		12	
5													
6		18		17		16		15		14		13	
7													
8		19		20		21		22		23		24	
9													
10		30		29		28		27		26		25	
11													
12		31		32		33		34		35		36	
13													

I, Timothy L. Lapham, in a field survey on November 20, 1997 do hereby state that under requirements of P.A. 74, Michigan P.A. of 1970, the corner points mentioned in lines 1 and 2 above were in conformance with regulations and rules therefore as required in the current manual of survey instructions of the United States Department of the Interior, Bureau of Land Management or by a decree of a Court of Law and /or that the corner points mentioned in lines 3, 4 and 5 above were in conformance with the rules of the Michigan Board of Land Surveyors or by a Decree of a Court of Law; established, re-established, monumented, recovered, found as expressed below:

NOTE: Not more than 2 corners, all in the same town and range, may be recorded on this certificate.

A. Description of original monument and accessories and/or subsequent restoration:
 GLO L. Clason 1837 set post
 Aspen 2" N19W 9 Lk
 Aspen 2" N52E 27 Lk
 Richardson 1970 Survey (S2,21N,2E)
 Corner not referenced, survey noted a search was made with no evidence found. A building occupied probable corner position.
 Wilcox 1980 Survey (oil well stake out)
 Used nail in roof of shed

B. Description of corner evidence found and/or method applied in restoring or reestablishing corner:
 No GLO corner found.
 History shows no corners were in place in 1970. Two irons were found. The North iron was capped with J. Wilcox cap #14102. It was located on an old fence line North and tree line East with remains of an old fence line. I contacted Wilcox's and they had no record of setting that corner. Their records show a shed on the corner the same as Richardson in 1970. A second iron was found also on the old fence line North but on approximately the centerline of a two track road West. This iron was on the North line of the Section 2 survey by Richardson. No records were found as to the source of this iron. Lacking any evidence as to the source of these irons, they were both rejected. The corner was established by single proportionate measure between I-13 and K-13 which were previously established in the course of this survey. The position as established is believed to be the best reestablishment of the GLO corner.


C. Description of monument for corner and accessories established to perpetuate locating the position of the corner:

Set 5/8"x36" rerod with 3-1/4" Aluminum Ogemaw Remon cap marked "27595 1997"
 S22W 140.08 Power pole
 N30W 43.15 10" W. Pine
 S30E 149.24 14" Twin W. Pine
 N58E 119.42 9" W. Pine
 West 9.24 5/8"x36" rerod with 3-1/4" Aluminum Ogemaw Remon cap (J-1, 21N, 2E)

Approved by Peer Review

1120-07 mm JLL
 DATE INITIALS

Signed by [Signature]
 Surveyor's Michigan License No. 27595

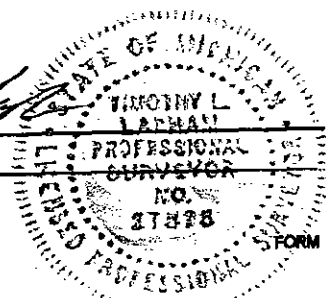

Date 12/24/97