

SURVEY &  
REMONUMENTATION

MAR 19 1998

OGEMAW COUNTY REMONUMENTATION

SECTION

LAND CORNER RECORDATION CERTIFICATE  
Filing Requirement of Act 74, Mich. P.A. 1970

For corners in

Ogemaw (County)	Located In:	Corner Code #
1. Public Land Survey	T <sup>22N</sup> R <sup>2E</sup>	K-1
	T R	
	T R	
	T R	
2. Property Controlling in Section	S T R	
	S T R	
3. Miscellaneous Property in Sec.	S T R	
	S T R	

LIBER 3 PAGE 132  
STATE OF MICHIGAN  
OGEMAW COUNTY  
RECORDED  
26 Dec 1997 2:51:41 PM  
WANDA MUZIK  
REGISTER OF DEEDS  
Register of Deeds Stamp & File Number

4. Lot No. \_\_\_\_\_, Recorded Plat \_\_\_\_\_  
5. Private Claims \_\_\_\_\_

I, Timothy L. Lapham, in a field survey on December 11, 1997 do hereby state that under requirements of P.A. 74, Michigan P.A. of 1970, the corner points mentioned in lines 1 and 2 above were in conformance with regulations and rules therefore as required in the current manual of survey instructions of the United States Department of the Interior, Bureau of Land Management or by a decree of a Court of Law and/or that the corner points mentioned in lines 3, 4 and 5 above were in conformance with the rules of the Michigan Board of Land Surveyors or by a Decree of a Court of Law; established, re-established, monumented, recovered, found as expressed below:

NOTE: Not more than 2 corners, all in the same town and range, may be recorded on this certificate.

	A	B	C	D	E	F	G	H	I	J	K	L
1												
2	6			5		4			3		2	1
3												
4	7			8		9			10		11	12
5												
6	18			17		16			15		14	13
7												
8	19			20		21			22		23	24
9												
10	30			29		28			27		26	25
11												
12	31			32		33			34		35	36
13												

A. Description of original monument and accessories and/or subsequent restoration:  
GLO - B. Hall 1846 set post  
Intersect 19 Lk West of post  
Cedar 8" S20W 9 Lk  
Hemlock 8" S52E 10 Lk  
Stream 50 Lk rapid C East  
at 81.22 - 80.50 + .72 ch South  
Campbell 1974 Survey (L1, P394)  
No witnesses - distances S & W

Caldwell 1976 Survey (L2, P167)  
Shows 6.25 offset at N 1/4, Sec 2  
No dist or wit to K-1  
Caldwell 1976 Survey (L2, P173)  
Ref to K-13, 23N, 2E as 12.5' West  
Sec break dist N & W

Lapham 1990 Survey (N901722)  
Found 5/8" iron bar  
N33W 59.87 power pole  
N36E 56.68 power pole  
S52W 95.42 8" cedar  
S64E 55.38 guard rail

(CONTINUED ON BACK)

B. Description of corner evidence found and/or method applied in restoring or reestablishing corner:  
K-1 - T22N, R2E 1997 field

No evidence of GLO corner. Found 2 irons 12.58 apart (GLO 12.54) K-1 to be West corner. Stream is at approximate GLO call South. Traverse to adjacent irons West and South matches Campbell 1974 survey. Traverse to I-1 (I-13, T23N, R2E) and to K-11 and D-12 match Caldwell 1976 survey. Lapham 1990 survey used K-13 iron as K-1, this survey was rejected as incorrect corner. Iron matches Lapham 1995 LCRC witnesses and Woods 1996 survey.

Accepted found iron as best evidence of correct corner position.

C. Description of monument for corner and accessories established to perpetuate locating the position of the corner:


Set 5/8"x36" rered with 3-1/4" Aluminum Ogemaw Remon cap marked "27595 1997"  
N55E 64.74 utility pole  
East 12.58 K-13, T23N R2E  
S57E 44.56 guard rail post  
S08W 109.40 utility pole  
N25W 53.53 utility pole  
12' West and 4' South of intersection centerline roads

Approved by Peer Review

12-11-97 [Signature] [Signature]  
DATE INITIALS

Signed by [Signature]  
Surveyor's Michigan License No. 27595

Date 12/24/97

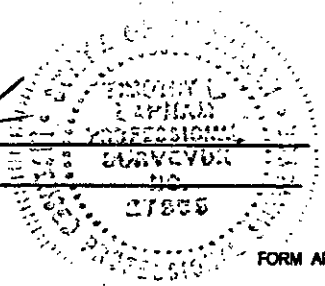

CONTINUATION OF PART A

Lapham 1995 LCRC (L3, P10)  
Found 1/2" iron rod  
N45E 64.71 utility pole  
East 12.50 1/2" iron rod  
S35E 137.00 NW cor farm house  
S01E 109.38 utility pole

Woods 1996 Survey (L6, P238)  
Found 1/2" bar 12.55 West of K-13,  
T23N, R2E