

**Ogemaw County Remonumentation**  
**LAND CORNER RECORDATION CERTIFICATE**  
**Filing Requirement of Act 74, Mich. P.A. 1970**

FEB 24 2000

For corners in

Ogemaw  
(County)

Located in:

Corner Code #

SECTION

1. Public Land Survey

T22N R02E

M-8

T22N R03E

A-8

T R

T R

T R

T R

T R

T R

T R

2. Property Controlling In Section

S

T R

3. Miscellaneous Property in Sec.

S


T R

S

T R

S

T R

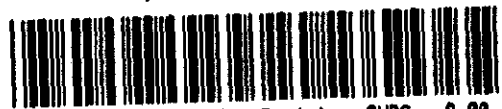

**3006789**

Page: 1 of 1  
12/27/1999 09:09A  
L-3 P-298

Handa Muzik, Ogemaw Co. Register SURC 9.00

Register of Deeds Stamp & File Number

4. Lot No. \_\_\_\_\_, Recorded Plat \_\_\_\_\_  
 5. Private Claims \_\_\_\_\_

I, Timothy L Lapham, in a field survey on December, 19 99 do hereby state that under requirements of P.A. 74, Michigan P.A. of 1970, the corner points mentioned in lines 1 and 2 above were in conformance with regulations and rules therefore as required in the current manual of survey instructions of the United States Department of the Interior, Bureau of Land Management or by a decree of a Court of Law and/or that the corner points mentioned in lines 3, 4 and 5 above were in conformance with the rules of the Michigan Board of Land Surveyors or by a Decree of a Court of Law; established, re-established, monumented, recovered, found as expressed below:

**NOTE: Not more than 2 corners, all in the same town and range, may be recorded on this certificate**

|    | A | B  | C | D  | E | F  | G | H  | I | J  | K | L  | M |
|----|---|----|---|----|---|----|---|----|---|----|---|----|---|
| 1  |   |    |   |    |   |    |   |    |   |    |   |    |   |
| 2  |   | 6  |   | 5  |   | 4  |   | 3  |   | 2  |   | 1  |   |
| 3  |   |    |   |    |   |    |   |    |   |    |   |    |   |
| 4  |   | 7  |   | 8  |   | 9  |   | 10 |   | 11 |   | 12 |   |
| 5  |   |    |   |    |   |    |   |    |   |    |   |    |   |
| 6  |   | 18 |   | 17 |   | 16 |   | 15 |   | 14 |   | 13 |   |
| 7  |   |    |   |    |   |    |   |    |   |    |   |    |   |
| 8  |   | 19 |   | 20 |   | 21 |   | 22 |   | 23 |   | 24 |   |
| 9  |   |    |   |    |   |    |   |    |   |    |   |    |   |
| 10 |   | 30 |   | 29 |   | 28 |   | 27 |   | 26 |   | 25 |   |
| 11 |   |    |   |    |   |    |   |    |   |    |   |    |   |
| 12 |   | 31 |   | 32 |   | 33 |   | 34 |   | 35 |   | 36 |   |
| 13 |   |    |   |    |   |    |   |    |   |    |   |    |   |

A. Description of original monument and accessories and/or subsequent restoration:

GLO by L. Clason, 1838, Post  
 N47W 13 Hard Maple  
 S75W 37 11" Hemlock

MDOT Road Plans, No material  
 West 1.58 Centerline M-33  
 Sta = 28+31.65

Consumers Power Survey, 1965+-  
 Set Pk nail from RAW marker  
 West 5.0 Highway Marker  
 SW 84.4 Highway Marker  
 SE 64.63 Highway Marker


Approved by Peer Review

12-16-99 JLR  
 DATE INITIALS

B. Description of corner evidence found and/or method applied in restoring or reestablishing corner:  
 No GLO evidence found. Found monument box. Found 3 - 1965 witnesses approximately from center of box. Set iron in center of box. Distances North and South then approximately match 1965 distances. Accepted established corner as best available evidence of correct corner position.

C. Description of monument for corner and accessories established to perpetuate locating the position of the corner:

Set 5/8"x3/8" rerod w/ aluminum remon cap  
 East 49.42 Right-of-way Marker  
 S50E 64.08 Right-of-way Marker  
 S52W 64.34 Right-of-way Marker  
 West 50.28 Right-of-way Marker  
 West 0.5 Centerline M-33

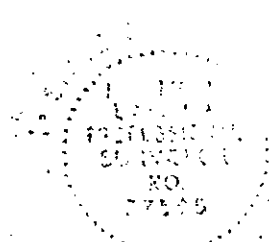

Signed by [Signature]  
 Surveyor's Michigan License No. 27595

Date 12/23/1999