

Ogemaw County Remonumentation

LAND CORNER RECORDATION CERTIFICATE
Filing Requirement of Act 74, Mich. P.A. 1970

RECEIVED &
FEB 24 2000

For corners in

Ogemaw Located in: Corner Code #
(County)

SECTION

1. Public Land Survey	T22N R02E	M-2
	T 22N R 03E	A-2 ✓
	T R	
	T R	
2. Property Controlling In Section	S T R	
	S T R	
3. Miscellaneous Property in Sec.	S T R	
	S T R	



3006874
Page: 1 of 1
12/28/1999 11:01A
L-4 P-25
Handa Muzik, Ogemaw Co. Register SURC 9.00

Register of Deeds Stamp & File Number

4. Lot No. _____, Recorded Plat _____
5. Private Claims _____

I, Timothy L. Lapham, in a field survey on December, 19 99 do hereby state that under requirements of P.A. 74, Michigan P.A. of 1970, the corner points mentioned in lines 1 and 2 above were in conformance with regulations and rules therefore as required in the current manual of survey instructions of the United States Department of the Interior, Bureau of Land Management or by a decree of a Court of Law and/or that the corner points mentioned in lines 3, 4 and 5 above were in conformance with the rules of the Michigan Board of Land Surveyors or by a Decree of a Court of Law, established, re-established, monumented, recovered, found as expressed below:

NOTE: Not more than 2 corners, all in the same town and range, may be recorded on this certificate

1	A	B	C	D	E	F	G	H	I	J	K	L	H
2	6		5					3		2			1
3													
4	7		8					10		11			12
5													
6	18		17					15		14			13
7													
8	19		20					22		23			24
9													
10	30		29					27		26			25
11													
12	31		32					34		35			36
13													

A. Description of original monument and accessories and/or subsequent restoration:
GLO by L. Clason, 1838, Post
N25W 25 6" Beech
S50W 18 24" Hemlock

Survey by N. Caldwell, 1979, No material


MDOT Plans, Approximate corner only

Consumers Power Survey, 1965+-
Set Pk on line at fences East & West

Approved by Peer Review
12-16-99 JLK
DATE INITIALS

B. Description of corner evidence found and/or method applied in restoring or reestablishing corner:
No GLO evidence of corner found. Found iron matching distance M-1 to M-2 from 1979 survey. Corners do not match GLO plat distances. Corner does not match MDOT station of approximate line within 10'±. Overall mile is 241'± short of GLO distance per plat or 22 feet short per notes. Stream call North matches found iron closely. Iron is on fence line East and West per 1965 survey. Distances North and South do not match 1965 survey but it appears distances may be in error. Record 1965 distances are prorated to GLO notes but corner record shows it was set at fences not GLO proration. Accepted found iron on fences as best evidence of correct corner position.

C. Description of monument for corner and accessories established to perpetuate locating the position of the corner:
Set 5/8"x36" rerod w/aluminum remon cap
East 50.76 Fence Cor Post
S27E 85.70 14" Ash
N85W 49.0 Utility Pole
N20W 151.90 Wood Sign Post
East 3.0 Centerline M-33

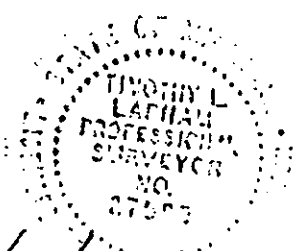

Signed by [Signature]
Surveyor's Michigan License No. 27595

Date 12/27/1999