

LAND CORNER RECORDATION CERTIFICATE  
Filing Requirement of Act 74, Mich. P.A. 1970

FEB 24 2000

For corners in

SECTION

Ogemaw Located in: Corner Code #  
(County)

1. Public Land Survey T22N R03E E-10  
T R  
T R  
T R

2. Property Controlling S T R  
in Section S T R

3. Miscellaneous S T R  
Property in Sec. S T R

3006785  
Page: 1 of 1  
12/27/1999 09:09A  
L-3 P-294  
Wanda Muzik, Ogemaw Co. Registrar SURC 9.00

Register of Deeds Stamp & File Number

4. Lot No. \_\_\_\_\_, Recorded Plat \_\_\_\_\_  
5. Private Claims \_\_\_\_\_

A	B	C	D	E	F	G	H	I	J	K	L	M
1												
2	6	5	4	3	2	1						
3												
4	7	8	9	10	11	12						
5												
6	18	17	16	15	14	13						
7												
8	19	20	21	22	23	24						
9												
10	30	29	28	27	26	25						
11												
12	31	32	33	34	35	36						
13												

I, Timothy L Lapham, in a field survey on December, 19 99 do hereby state that under requirements of P.A. 74, Michigan P.A. of 1970, the corner points mention in lines 1 and 2 above were in conformance with regulations and rules therefore as required in the current manual of survey instructions of the United States Department of the Interior, Bureau of Land Management or by a decree of a Court of Law and/or that the corner points mentioned in lines 3, 4 and 5 above were in conformance with the rules of the Michigan Board of Land Surveyors or by a Decree of a Court of Law, established, re-established, monumented, recovered, found as expressed below:

NOTE: Not more than 2 corners, all in the same town and range, may be recorded on this certificate


- A. Description of original monument and accessories and/or subsequent restoration:
- E-10: GLO by B.F. Hall, 1846, Post  
S53E 9 6" Cedar  
N41W 16 14" Hemlock  
Survey by N. Caldwell, 1976, Found 1/2" bar  
S63E 20.78 10" White Ash  
N58E 34.25 7" Twin Cedar  
S74W 24.70 6" Poplar  
South 32.0 C.L. Culvert
  - LCRC by S. Barnett, 1972, Found 1/2" rebar  
N60E 34.26 8" Cedar  
S58E 20.79 10" Ash  
S72W 24.59 4" Poplar  
Survey by S. Barnett, 1972, Found 1/2" rebar  
N60E 34.26 8" Cedar  
S58E 20.79 10" Ash  
S72W 24.59 4" Poplar
  - LCRC by N. Caldwell, 1977, Found 1/2" bar  
S63E 20.78 10" White Ash  
N58E 34.25 7" Twin Cedar  
S74W 24.70 6" Poplar  
South 32.0 C.L. Culvert  
Survey by T. Lapham, 1997, Found capped iron  
S63E 20.78 10" White Ash  
N58E 34.25 7" Twin Cedar  
S74W 24.70 6" Poplar  
South 32.0 C.L. Culvert
  - Survey by J. Richardson, 1970, Set 1/2"x24" bar at midpoint on line  
S63E 20.8 10" Ash  
N58E 34.25 7" Twin Cedar  
S74W 24.55 4" Poplar  
Survey by T. Lapham, 1994, Reset capped iron  
East 2.0 Centerline Road  
N59E 61.63 15" Red Pine

S17E 79.47 Fence Post  
S24W 97.67 12" Poplar

Approved by Peer Review  
TLL 12/23/99  
DATE INITIALS

B. Description of corner evidence found and/or method applied in restoring or reestablishing corner:  
E-10: No GLO evidence found. Found 1/2" capped iron (27595) and all 1994 survey witnesses. Witnesses of all LCRC's gone except 1 - 1977 witness (culvert). Corner is close to midpoint on line between E-7 and E-11 per 1970 survey. Accepted found iron as best available evidence of correct corner position.

- C. Description of monument for corner and accessories established to perpetuate locating the position of the corner:  
E-10: Set 5/8"x36" rerod w/aluminum remon cap  
East 2.5 Centerline Road  
N59E 61.63 16" Red Pine  
S17E 79.47 Fence Post  
S24W 97.67 14" Poplar  
N59W 89.27 10" Cedar

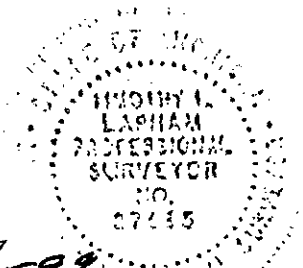

Signed by Timothy Lapham  
Surveyor's Michigan License No. 27595

Date 12/23/1999