

**SURVEY & REMONUMENTATION**

JUN 02 1994

**OGEMAW COUNTY REMONUMENTATION**

COMMISSION

**LAND CORNER RECORDATION CERTIFICATE**  
Filing Requirement of Act 74, Mich. P.A. 1970

For corners in

<u>OGEMAW</u> (County)	Located In:	Corner Code #
1. Public Land Survey	T <u>22N</u> R <u>3E</u>	<u>M-1</u>
	T _____ R _____	_____
	T _____ R _____	_____
	T _____ R _____	_____
2. Property Controlling in Section	S _____ T _____ R _____	_____
	S _____ T _____ R _____	_____
3. Miscellaneous Property in Sec.	S _____ T _____ R _____	_____
	S _____ T _____ R _____	_____
4. Lot No. _____, Recorded Plat _____		
5. Private Claims _____		

RECORDED  
OGEMAW COUNTY, MICH.  
LIBER 2 PAGE 217

93 DEC 29 PM 2:57

*Wanda Juzgik*  
REGISTER OF DEEDS  
OGEMAW COUNTY

Register of Deeds Stamp & File Number

A	B	C	D	E	F	G	H	I	J	K	L	M
2	6	5	4	3	2	1						
3												
4	7	8	9	10	11	12						
5												
6	18	17	16	15	14	13						
7												
8	19	20	21	22	23	24						
9												
10	30	29	28	27	26	25						
11												
12	31	32	33	34	35	36						
13												

I, TIMOTHY L. LAPHAM, in a field survey on December, 1993, do hereby certify that under requirements of P.A. 74, Michigan P.A. of 1970, the corner points mentioned in lines 1 and 2 above were in conformance with regulations and rules therefore as required in the current manual of survey instructions of the United States Department of the Interior, Bureau of Land Management or by a decree of a Court of Law and/or that the corner points mentioned in lines 3, 4 and 5 above were in conformance with the rules of the Michigan Board of Land Surveyors or by a Decree of a Court of Law; established, re-established, monumented, re-monumented, recovered, found as expressed below:

**NOTE: Not more than 4 corners, all in the same town and range, may be recorded on this certificate.**

A. Description of original monument and accessories and/or subsequent restoration:


M-1: 1838, L. CLASON, SET POST, Y. PINE, 20" N30E 49LKS; BEECH 10" N26W 36LKS; 12/9/1925, G. H. HOLLISTER, PLAT OF HENDERSON BEECH, 1-54, NO CORNER MATERIAL, NO WITNESSES; 3/1/1982, HIGGINS, ASSESSOR'S PLAT OF INDIANA ROAD, 6-14, NO COR MAT, 4 WITS; 8/15/1983, HIGGINS, (132) 3-426, NO COR MAT, NO WITS; 1/14/1985, T. LAPHAM, (132), SEE DOSSIER, COR MAT, 5 WITS; 1/27/1988, D. LEDY, LCRC 1-373, COR MAT, 4 WITS;

B. Description of corner evidence found and/or method applied in restoring or reestablishing corner:

M-1: NO CORNER FOUND DUE TO RECENT ROAD CONSTRUCTION. RESET CORNER FROM PREVIOUS WITNESSES. N15E 32.45' POWER POLE 8" MAPLE S61E 77.5' ALL REMAINING WITNESSES GONE ACCEPTED FOUND CORNER AS BEST EVIDENCE OF POSITION OF ORIGINAL CORNER. THIS CORNER ESTABLISHED IN OGEMAW COUNTY REMONUMENTATION PROGRAM. SEE DOSSIER FOR DETAILED REPORT.

C. Description of monument for corner and accessories established to perpetuate locating the position of the corner:

M-1: SET 5/8" X 36" REROD WITH 3" OGEMAW COUNTY MONUMENT CAP. AZ 60° 32.45' SPIKE IN SE FACE UTILITY POLE AZ 125° 77.50' SPIKE IN SW FACE 8" MAPLE AZ 209° 91.06' SPIKE IN SE FACE 24" WEEPING WILLOW AZ 327° 58.58' SPIKE IN NE FACE 9" MAPLE

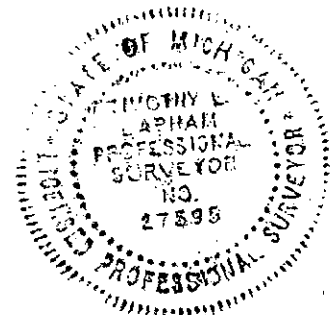

Signed by

*Timothy L. Lapham*

Date

12/28/93

Surveyor's Michigan License No. 27595