

**SURVEY & REMONUMENTATION**

JUN 02 1994

COMMISSION

**OGEMAW COUNTY REMONUMENTATION  
LAND CORNER RECORDATION CERTIFICATE  
Filing Requirement of Act 74, Mich. P.A. 1970**

RECORDED  
OGEMAW COUNTY, MI.  
LIBER 2 PAGE 219  
23 DEC 29 PM 2:57

*Wanda Muzik*  
REGISTER OF DEEDS  
OGEMAW COUNTY

For corners in

OGEMAW (County)	Located In:	Corner Code #
1. Public Land Survey	T <u>22N</u> R <u>3E</u>	<u>M-4</u>
	T _____ R _____	_____
	T _____ R _____	_____
	T _____ R _____	_____
2. Property Controlling in Section	S _____ T _____ R _____	_____
	S _____ T _____ R _____	_____
3. Miscellaneous Property in Sec.	S _____ T _____ R _____	_____
	S _____ T _____ R _____	_____
4. Lot No. _____, Recorded Plat _____		
5. Private Claims _____		

Register of Deeds Stamp & File Number

	A	B	C	D	E	F	G	H	I	J	K	L	M
2	6	5	4	3	2	1							
3													
4	7	8	9	10	11	12							
5													
6	18	17	16	15	14	13							
7													
8	19	20	21	22	23	24							
9													
10	30	29	28	27	26	25							
11													
12	31	32	33	34	35	36							
13													

TIMOTHY L. LAPHAM, in a field survey on December, 1993, do hereby certify that under requirements of P.A. 74, Michigan P.A. of 1970, the corner points mentioned in lines 1 and 2 above were in conformance with regulations and rules therefore as required in the current manual of survey instructions of the United States Department of the Interior, Bureau of Land Management or by a decree of a Court of Law and/or that the corner points mentioned in lines 3, 4 and 5 above were in conformance with the rules of the Michigan Board of Land Surveyors or by a Decree of a Court of Law; established, re-established, monumented, re-monumented, recovered, found as expressed below:

**NOTE: Not more than 4 corners, all in the same town and range, may be recorded on this certificate.**

**A. Description of original monument and accessories and/or subsequent restoration:**


M-4: 1838, CLASON, POST, W. PINE 36" S55W 11LKS; HEMLOCK 10" N39W 4LKS; 7/29/1978, HIGGINS, (132) NOT RECORDED, CORNER MATERIAL, NO WITNESSES; 2/25/1987, LAPHAM, (132) NOT RECORDED, COR MAT, 3 WITS; 4/13/1987, LAPHAM, (132) NOT RECORDED, COR MAT, 3 WITS;

**B. Description of corner evidence found and/or method applied in restoring or reestablishing corner:**

M-4: NO EVIDENCE OF GLO CORNER WITNESSES. FOUND 1/2" REROD. VERIFIED USING DISTANCE SOUTH FROM 7/1987 SURVEY AND WITNESSES FROM 2/1987 SURVEY.  
S20E 89.58' POWER POLE  
S45E 97.35' 18" ASH  
N45E 42.50' POWER POLE  
4/1987 SURVEY INDICATE POSSIBLE CORNER 2 1/2'+/- NORTH OF IRON, UNCONCLUSIVE ACCEPTED FOUND REROD AS BEST EVIDENCE OF POSITION OF ORIGINAL CORNER.  
THIS CORNER ESTABLISHED IN OGEMAW COUNTY REMONUMENTATION PROGRAM.  
SEE DOSSIER FOR DETAILED REPORT.

**C. Description of monument for corner and accessories established to perpetuate locating the position of the corner:**

M-4: SET 5/8" X 36" REROD WITH 3" OGEMAW COUNTY MONUMENTATION CAP  
AZ 167° 89.29' SPIKE IN WEST FACE POWER POLE  
AZ 136° 97.04' SPIKE IN NE FACE 17" ASH  
AZ 42° 42.46' SPIKE IN SE FACE POWER POLE  
AZ 151° 153.41' SW CORNER STONE FOUNDATION WALL FOR HOUSE

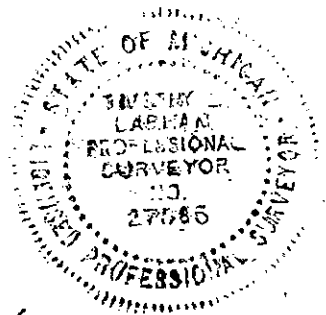

Signed by *[Signature]*

Date 12/28/93

Surveyor's Michigan License No. 27595