

**SURVEY &
REMONUMENTATION**

JUN 02 1994

COMMISSION

**OGEMAW COUNTY REMONUMENTATION
LAND CORNER RECORDATION CERTIFICATE
Filing Requirement of Act 74, Mich. P.A. 1970**

RECORDED
OGEMAW COUNTY MI
LIBER 2 PAGE 220

For corners in

<u>OGEMAW</u> <small>(County)</small>	Located In:	Corner Code #
1. Public Land Survey	T <u>22N</u> R <u>3E</u>	<u>M-5</u>
	T _____ R _____	_____
	T _____ R _____	_____
	T _____ R _____	_____
2. Property Controlling in Section	S _____ T _____ R _____	_____
	S _____ T _____ R _____	_____
3. Miscellaneous Property in Sec.	S _____ T _____ R _____	_____
	S _____ T _____ R _____	_____
4. Lot No. _____, Recorded Plat _____		
5. Private Claims _____		

93 DEC 29 PM 2:57

Wanda Mizgik
REGISTER OF DEEDS
OGEMAW COUNTY

Register of Deeds Stamp & File Number

TIMOTHY L. LAPHAM in a field survey on December, 1993, do hereby certify that under requirements of P.A. 74, Michigan P.A. of 1970, the corner points mentioned in lines 1 and 2 above were in conformance with regulations and rules therefore as required in the current manual of survey instructions of the United States Department of the Interior, Bureau of Land Management or by a decree of a Court of Law and/or that the corner points mentioned in lines 3, 4 and 5 above were in conformance with the rules of the Michigan Board of Land Surveyors or by a Decree of a Court of Law; established, re-established, monumented, re-monumented, recovered, found as expressed below:

	A	B	C	D	E	F	G	H	I	J	K	L
2	6	5	4	3	2	1						
3												
4	7	8	9	10	11	12						
5												
6	18	17	16	15	14	13						
7												
8	19	20	21	22	23	24						
9												
10	30	29	28	27	26	25						
11												
12	31	32	33	34	35	36						
13												

NOTE: Not more than 4 corners, all in the same town and range, may be recorded on this certificate.

A. Description of original monument and accessories and/or subsequent restoration:


M-5: 1838, CLASON, POST, HARD MAPLE 10" S51W 11LKS; LYNN 36" N24W 35LKS; 7/29/1978, HIGGINS, (132) NOT RECORDED, CORNER MATERIAL, NO WITNESSES; 11/26/1984, LAPHAM, (132) NOT RECORDED, COR MAT, 3 WITS;

B. Description of corner evidence found and/or method applied in restoring or reestablishing corner:

M-5: NO CORNER FOUND DUE TO RECENT ROAD CONSTRUCTION. RESET CORNER FROM 1984 SURVEY. VERIFIED WITH WITNESS AND DISTANCES NORTH AND SOUTH AS SHOWN ON 1978 AND 1984 SURVEYS. S50E 43.7' POWER POLE ACCEPTED ESTABLISHED CORNER AS BEST EVIDENCE OF ORIGINAL POSITION OF CORNER. THIS CORNER ESTABLISHED IN OGEMAW COUNTY REMONUMENTATION PROGRAM. SEE DOSSIER FOR DETAILED REPORT.

C. Description of monument for corner and accessories established to perpetuate locating the position of the corner:

M-5: SET 5/8" X 36" REROD WITH 3" OGEMAW COUNTY MONUMENTATION CAP
AZ 129° 43.42' SPIKE IN POWER POLE
AZ 154° 98.00' NW CORNER OF CONCRETE FOUNDATION OF HOUSE
AZ 250° 57.90' SPIKE IN SOUTH FACE 3" SPRUCE
AZ 109° 95.96' SPIKE IN NORTH FACE 12" RED PINE

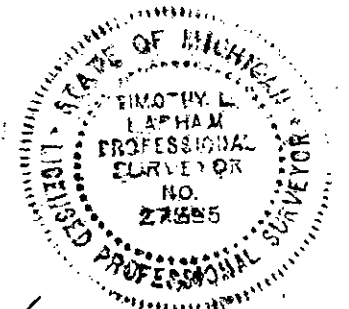

Signed by *[Signature]*

Date 12/28/93

Surveyor's Michigan License No. 27595