

**SURVEY &
REMONUMENTATION**

JUN 02 1994

**OGEMAW COUNTY REMONUMENTATION
LAND CORNER RECORDATION CERTIFICATE
Filing Requirement of Act 74, Mich. P.A. 1970**

For corners in **OGEMAW** COMMISSION

OGEMAW (County)	Located In:	Corner Code ≠
1. Public Land Survey	T <u>22N</u> R <u>3E</u>	<u>M-7</u>
	T _____ R _____	_____
	T _____ R _____	_____
	T _____ R _____	_____
2. Property Controlling in Section	S _____ T _____ R _____	_____
	S _____ T _____ R _____	_____
3. Miscellaneous Property in Sec.	S _____ T _____ R _____	_____
	S _____ T _____ R _____	_____

RECORDED
OGEMAW COUNTY, MI
LIBER 2 PAGE 222
93 DEC 29 PM 2:58
Wanda Mujik
REGISTER OF DEEDS
OGEMAW COUNTY
Register of Deeds Stamp & File Number

4. Lot No. _____, Recorded Plat _____
5. Private Claims _____

TIMOTHY L. LAPHAM, in a field survey on December, 1993,
do hereby certify that under requirements of P.A. 74, Michigan P.A. of 1970, the corner points mentioned
in lines 1 and 2 above were in conformance with regulations and rules therefore as required in the
current manual of survey instructions of the United States Department of the Interior, Bureau of Land
Management or by a decree of a Court of Law and/or that the corner points mentioned in lines 3, 4 and 5
above were in conformance with the rules of the Michigan Board of Land Surveyors or by a Decree of a
Court of Law; established, re-established, monumented, re-monumented, recovered, found as
expressed below:

**NOTE: Not more than 4 corners, all in the same town and range, may be recorded
on this certificate.**

A. Description of original monument and accessories and/or subsequent restoration:

M-7: 1838, CLASON, POST, HEMLOCK 15" S85.5W 40LKS; HEMLOCK 11" N26W 25LKS;
UNDATED, J. RICHARDSON, CORNER MATERIAL, 3 WITNESSES;
UNDATED, COUNTY ROAD PLANS, CORNER MATERIAL, 3 WITNESSES;
10/1980 K. OSTLING, CORNER MATERIAL, 2 WITNESSES;

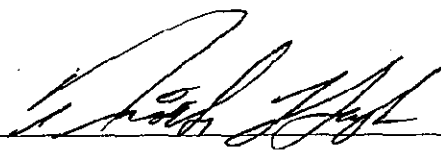
B. Description of corner evidence found and/or method applied in restoring or reestablishing corner:

M-7: NO GLO CORNER FOUND. RESET CORNER FROM PREVIOUS SURVEYS.
ACCEPTED REESTABLISHED CORNER AS BEST EVIDENCE OF ORIGINAL CORNER POSITION.
THIS CORNER ESTABLISHED IN OGEMAW COUNTY REMONUMENTATION PROGRAM. SEE DOSSIER FOR
DETAILS.

C. Description of monument for corner and accessories established to perpetuate locating the position of the corner:

M-7: SET 5/8" X 36" REROD WITH 3" OGEMAW COUNTY MONUMENT CAP IN MONUMENT BOX.
AZ 170° 128.37' SPIKE NE FACE UTILITY POLE
AZ 198° 126.96' SPIKE SE FACE FENCE POST
AZ 337° 96.62' SPIKE SW FACE 15" MAPLE
AZ 57° 72.14' SPIKE NW FACE 9" ASH
AZ 90° 1'+/- CENTER LINE PAVEMENT

	A	B	C	D	E	F	G	H	I	J	K	L
2	6	5	4	3	2	1						
3												
4	7	8	9	10	11	12						
5												
6	18	17	16	15	14	13						
7												
8	19	20	21	22	23	24						
9												
10	30	29	28	27	26	25						
11												
12	31	32	33	34	35	36						
13												

Signed by 
Surveyor's Michigan License No. 27595

Date 12/28/93

