

**SURVEY &  
REMONUMENTATION**

JUN 02 1994

**OGEMAW COUNTY REMONUMENTATION  
LAND CORNER RECORDATION CERTIFICATE  
Filing Requirement of Act 74, Mich. P.A. 1970**

RECORDED  
OGEMAW COUNTY, MI.  
LIBER 2 PAGE 224

93 DEC 29 PM 2:58

*Wanda Kuzik*  
REGISTER OF DEEDS  
OGEMAW COUNTY

Register of Deeds Stamp & File Number

For corners in OGEMAW COMMISSION  
(County)

	Located In:	Corner Code #:
1. Public Land Survey	T <u>22N</u> R <u>3E</u>	<u>M-9</u>
	T _____ R _____	_____
	T _____ R _____	_____
	T _____ R _____	_____
2. Property Controlling in Section	S _____ T _____ R _____	_____
	S _____ T _____ R _____	_____
3. Miscellaneous Property in Sec.	S _____ T _____ R _____	_____
	S _____ T _____ R _____	_____

4. Lot No. \_\_\_\_\_, Recorded Plat \_\_\_\_\_  
5. Private Claims \_\_\_\_\_

TIMOTHY L. LAPHAM in a field survey on December, 1993, do hereby certify that under requirements of P.A. 74, Michigan P.A. of 1970, the corner points mentioned in lines 1 and 2 above were in conformance with regulations and rules therefore as required in the current manual of survey instructions of the United States Department of the Interior, Bureau of Land Management or by a decree of a Court of Law and/or that the corner points mentioned in lines 3, 4 and 5 above were in conformance with the rules of the Michigan Board of Land Surveyors or by a Decree of a Court of Law; established, re-established, monumented, re-monumented, recovered, found as expressed below:

**NOTE: Not more than 4 corners, all in the same town and range, may be recorded on this certificate.**

A. Description of original monument and accessories and/or subsequent restoration:

M-9: 1838, CLASON, POST, HEMLOCK 9" S78W 22LKS; HEMLOCK 9" N66W 16LKS; UNDATED, J. RICHARDSON, SURVEY, CORNER MATERIAL, NO WITNESSES; UNDATED, COUNTY ROAD PLANS, COR MAT, 3 WITS; 10/1980, K. OSTLING, SURVEY, COR MAT, NO WITS; 5/14/1991, T. LAPHAM, SURVEY, NO COR MAT, 3 WITS; UNDATED, STATE HIGHWAY PLANS, COR MAT, 3 WITS;


B. Description of corner evidence found and/or method applied in restoring or reestablishing corner:

M-9: NO EVIDENCE OF GLO CORNER OR WITNESSES. FOUND 1/2" X 36" REROD IN MON BOX.  
S35W 73.00' GAS LINE MARKER  
S45E 97.60' POWER POLE  
N50W 67.14' LIGHT POLE  
N21W 77.31' POWER POLE  
ACCEPTED FOUND CORNER BEST EVIDENCE OF POSITION OF ORIGINAL CORNER.  
THIS CORNER ESTABLISHED IN OGEMAW COUNTY REMONUMENTATION PROGRAM.  
SEE DOSSIER FOR DETAILED REPORT.

C. Description of monument for corner and accessories established to perpetuate locating the position of the corner:

M-9: SET 5/8" X 36" REROD WITH 3" OGEMAW COUNTY MONUMENT CAP IN MONUMENT BOX.  
AZ 153° 97.35' MDOT NAIL & TAG NE FACE UTILITY POLE  
AZ 331° 67.15' MDOT NAIL & TAG SW FACE LIGHT POLE  
AZ 17° 178.73' MDOT NAIL & TAG WEST FACE FENCE CORNER POST  
AZ 49° 175.23' MDOT NAIL & TAG SE FACE FENCE POST  
AZ 76° 220.86' NAIL SE FACE OF FENCE CORNER POST

	A	B	C	D	E	F	G	H	I	J	K	L
2	6	5	4	3	2	1						
3												
4	7	8	9	10	11	12						
5												
6	18	17	16	15	14	13						
7												
8	19	20	21	22	23	24						
9												
10	30	29	28	27	26	25						
11												
12	31	32	33	34	35	36						
13												

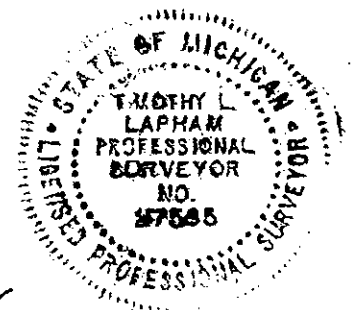

Signed by [Signature]

Date 12/28/93

Surveyor's Michigan License No. 27595