

**SURVEY &
REMONUMENTATION**

JUN 0 2 1994

COMMISSION

For corners in

OGEMAW COUNTY REMONUMENTATION

LAND CORNER RECORDATION CERTIFICATE
Filing Requirement of Act 74, Mich. P.A. 1970

RECORDED
OGEMAW COUNTY, MICH.
LIBER 2 PAGE 225

93 DEC 29 PM 2:58

Wanda Yuzik
REGISTER OF DEEDS
OGEMAW COUNTY

Register of Deeds Stamp & File Number

<u>OGEMAW</u> (County)	Located In:	Corner Code #
1. Public Land Survey	T <u>22N</u> R <u>3E</u>	<u>M-10</u>
	T _____ R _____	_____
	T _____ R _____	_____
	T _____ R _____	_____
2. Property Controlling in Section	S _____ T _____ R _____	_____
	S _____ T _____ R _____	_____
3. Miscellaneous Property in Sec.	S _____ T _____ R _____	_____
	S _____ T _____ R _____	_____
4. Lot No. _____, Recorded Plat _____		
5. Private Claims _____		

A	B	C	D	E	F	G	H	I	J	K	L
2	6	5	4	3	2	1					
3											
4	7	8	9	10	11	12					
5											
6	18	17	16	15	14	13					
7											
8	19	20	21	22	23	24					
9											
10	30	29	28	27	26	25					
11											
12	31	32	33	34	35	36					
13											

TIMOTHY L. LAPHAM, in a field survey on December, 1993, do hereby certify that under requirements of P.A. 74, Michigan P.A. of 1970, the corner points mentioned in lines 1 and 2 above were in conformance with regulations and rules therefore as required in the current manual of survey instructions of the United States Department of the Interior, Bureau of Land Management or by a decree of a Court of Law and/or that the corner points mentioned in lines 3, 4 and 5 above were in conformance with the rules of the Michigan Board of Land Surveyors or by a Decree of a Court of Law; established, re-established, monumented, re-monumented, recovered, found as expressed below:

NOTE: Not more than 4 corners, all in the same town and range, may be recorded on this certificate.

A. Description of original monument and accessories and/or subsequent restoration:


M-10: 1838, CLASON, POST, WHITE PINE 15" S28.5W 40LKS; HEMLOCK 8" N74W 31LKS; UNDATED COUNTY ROAD PLANS

B. Description of corner evidence found and/or method applied in restoring or reestablishing corner:

M-10: REESTABLISHED FROM WITNESS AND STATIONING ON ROAD PLANS.
ACCEPTED REESTABLISHED CORNER AS BEST EVIDENCE OF POSITION OF ORIGINAL CORNER.
THIS CORNER ESTABLISHED IN OGEMAW COUNTY REMONUMENTATION PROGRAM.
SEE DOSSIER FOR DETAILED REPORT.

C. Description of monument for corner and accessories established to perpetuate locating the position of the corner:

M-10: SET 5/8" X 36" REROD WITH 3" OGEMAW COUNTY MONUMENT CAP IN MONUMENT BOX.
AZ 93° 46.24' SPIKE SOUTH FACE FENCE POST
AZ 269° 45.47' SPIKE SOUTH FACE FENCE POST
AZ 238° 124.75' SE CORNER CONCRETE FOUNDATION OF BARN
AZ 20° 179.22' SPIKE SE FACE POWER POLE
AZ 270° 1'+/- CENTER LINE PAVEMENT

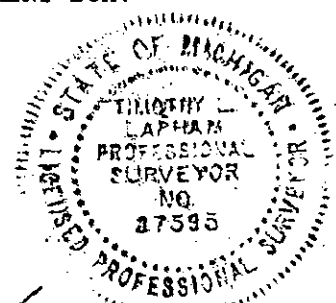

Signed by *[Signature]*

Date 12/28/93

Surveyor's Michigan License No. 27595