

SURVEY & REMONUMENTATION

JUN 02 1994

COMMISSION

OGEMAW COUNTY REMONUMENTATION

LAND CORNER RECORDATION CERTIFICATE

Filing Requirement of Act 74, Mich. P.A. 1970

For corners in

<u>OGEMAW</u> (County)	Located In:	Corner Code #
1. Public Land Survey	T <u>22N</u> R <u>3E</u>	<u>M-11</u>
	T _____ R _____	_____
	T _____ R _____	_____
	T _____ R _____	_____
2. Property Controlling in Section	S _____ T _____ R _____	_____
	S _____ T _____ R _____	_____
3. Miscellaneous Property in Sec.	S _____ T _____ R _____	_____
	S _____ T _____ R _____	_____
4. Lot No. _____, Recorded Plat _____		
5. Private Claims _____		

RECORDED
OGEMAW COUNTY, MI.
1088 2 PAGE 226
93 DEC 29 PM 2:59
Wanda Tuzik
REGISTER OF DEEDS
OGEMAW COUNTY
Register of Deeds Stamp & File Number

A	B	C	D	E	F	G	H	I	J	K	L	N
2	6	5	4	3	2	1						
3												
4	7	8	9	10	11	12						
5												
6	18	17	16	15	14	13						
7												
8	19	20	21	22	23	24						
9												
10	30	29	28	27	26	25						
11												
12	31	32	33	34	35	36						
13												

TIMOTHY L. LAPHAM, in a field survey on December, 1993, do hereby certify that under requirements of P.A. 74, Michigan P.A. of 1970, the corner points mentioned in lines 1 and 2 above were in conformance with regulations and rules therefore as required in the current manual of survey instructions of the United States Department of the Interior, Bureau of Land Management or by a decree of a Court of Law and/or that the corner points mentioned in lines 3, 4 and 5 above were in conformance with the rules of the Michigan Board of Land Surveyors or by a Decree of a Court of Law; established, re-established, monumented, re-monumented, recovered, found as expressed below:

NOTE: Not more than 4 corners, all in the same town and range, may be recorded on this certificate.

A. Description of original monument and accessories and/or subsequent restoration:

M-11: 1838 CLASON, POST, W. PINE 24" S68W 26L., HEMLOCK 10" N64W 7L., 8/13/1971 CALDWELL (132) 1-76, NO CORNER MATERIAL OR WITNESSES
8/1971 CALDWELL LCRC 1-19, CORNER MATERIAL, 3 WITNESSES
9/30/1985 T. LAPHAM (132) 4-1, CORNER MATERIAL, 3 WITNESSES


B. Description of corner evidence found and/or method applied in restoring or reestablishing corner:

M-11: FOUND 3/8" REROD IN MONUMENT BOX 3.5' WEST OF CENTERLINE
FOUND WITNESS: N65E 56.0 TW. 10" BIRCH
DUG TO 3' DEEP WITH NO ADDITION EVIDENCE FOUND

ACCEPTED FOUND CORNER AS BEST EVIDENCE OF ORIGINAL CORNER POSITION.
THIS CORNER ESTABLISHED IN OGEMAW COUNTY REMONUMENTATION PROGRAM.
SEE DOSSIER FOR DETAILED REPORT.

C. Description of monument for corner and accessories established to perpetuate locating the position of the corner:

M-11: SET 5/8"x36" REROD WITH 3" OGEMAW COUNTY CAP IN MONUMENT BOX
AZ 66° 55.7' FACE OF BIRCH STUMP
AZ 89° 35.13' SPIKE IN S FACE OF NEW CORNER POST
AZ 41° 58.75' SPIKE IN SE FACE OF 14" ASH
AZ 78° 45.72' SPIKE IN N FACE OF 10" ASH
AZ 320° 22.41' 1/2" PS CAPPED REROD #27595
AZ 138° 63.51' SPIKE IN NE FACE 2" RED PINE

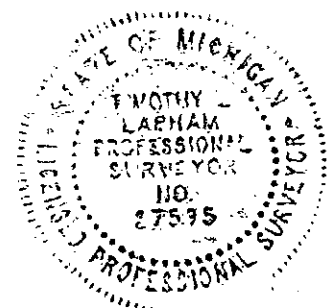

Signed by [Signature] Date 12/28/93

Surveyor's Michigan License No. 27595