

**SURVEY &  
REMONUMENTATION**

JUN 02 1994

COMMISSION

**OGEMAW COUNTY REMONUMENTATION**

**LAND CORNER RECORDATION CERTIFICATE  
Filing Requirement of Act 74, Mich. P.A. 1970**

RECORDED  
OGEMAW COUNTY M.  
LIBER 2 PAGE 227

93 DEC 29 PM 2:59

*Wanda Kuzik*  
REGISTER OF DEEDS  
OGEMAW COUNTY

Register of Deeds Stamp & File Number

For corners in

<u>OGEMAW</u> (County)	Located In:	Corner Code #
1. Public Land Survey	T <u>22N</u> R <u>3E</u>	<u>M-12</u>
	T _____ R _____	_____
	T _____ R _____	_____
	T _____ R _____	_____
2. Property Controlling in Section	S _____ T _____ R _____	_____
	S _____ T _____ R _____	_____
3. Miscellaneous Property in Sec.	S _____ T _____ R _____	_____
	S _____ T _____ R _____	_____
4. Lot No. _____, Recorded Plat _____		
5. Private Claims _____		

	A	B	C	D	E	F	G	H	I	J	K	L
2	6	5	4	3	2	1						
3												
4	7	8	9	10	11	12						
5												
6	18	17	16	15	14	13						
7												
8	19	20	21	22	23	24						
9												
10	30	29	28	27	26	25						
11												
12	31	32	33	34	35	36						
13												

TIMOTHY L. LAPHAM, in a field survey on November, 1993, do hereby certify that under requirements of P.A. 74, Michigan P.A. of 1970, the corner points mentioned in lines 1 and 2 above were in conformance with regulations and rules therefore as required in the current manual of survey instructions of the United States Department of the Interior, Bureau of Land Management or by a decree of a Court of Law and/or that the corner points mentioned in lines 3, 4 and 5 above were in conformance with the rules of the Michigan Board of Land Surveyors or by a Decree of a Court of Law; established, re-established, monumented, re-monumented, recovered, found as expressed below:

**NOTE: Not more than 4 corners, all in the same town and range, may be recorded on this certificate.**

A. Description of original monument and accessories and/or subsequent restoration:

M-12: 1836 L. CLASON; POST; CEDAR 7" S62W 28LK; LYNN 6" N31W 20LK  
8/13/1971 CALDWELL; SURVEY 1-76; DISTANCE N AND S  
8/1971 CALDWELL; LCRC 1-19; CORNER AND WITNESS  
1978+/- COUNTY ROAD PLANS; CORNER AND WITNESSES  
9/30/1985 LAPHAM; SURVEY 4-1; CORNER AND WITNESS  
1/1989 LAPHAM; LCRC 2-75; CORNER AND WITNESSES


B. Description of corner evidence found and/or method applied in restoring or reestablishing corner:

M-12: FOUND 3/8"x18" REROD IN MON. BOX IN CENTER OF ROAD; FOUND WITNESSES:  
N55W 61.0 POWER POLE  
S57E 66.77' 5" POPLAR (LATER 10")  
N86E 60.45' 10" ASH (LATER STUMP NOW BADLY DETERIORATED)  
N45E 85.46' 3" ASH (LATER 8" STUMP NOW BADLY DETERIORATED)

ACCEPTED FOUND CORNER AS BEST EVIDENCE OF ORIGINAL CORNER POSITION.  
THIS CORNER ESTABLISHED IN OGEMAW COUNTY REMONUMENTATION PROGRAM.  
SEE DOSSIER FOR DETAILED REPORT.

C. Description of monument for corner and accessories established to perpetuate locating the position of the corner:

M-12: SET 5/8"x36" REROD WITH OGEMAW COUNTY MONUMENT CAP IN MON. BOX  
AZ 311° 61.17' SPIKE IN SW FACE UTILITY POLE  
AZ 120° 66.54' SPIKE IN SW FACE 10" POPLAR  
AZ 30° 35.22' CAPPED IRON (LAPHAM)  
AZ 227° 29.81' CAPPED IRON (LAPHAM)  
AZ 46° 49.95' SPIKE IN NW FACE 5" ASH  
AZ 151° 84.23' SPIKE IN NE FACE 2" FIR

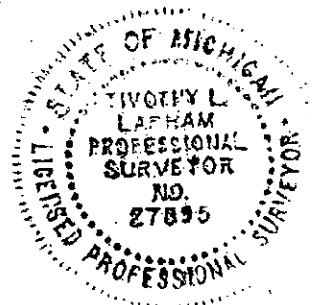

Signed by *Timothy L. Lapham*  
Surveyor's Michigan License No. 27595

Date 12/28/93