

**SURVEY & REMONUMENTATION**

MAY 28 1997

OGEMAW COUNTY REMONUMENTATION

LIBER 3 PAGE 93

COMMISSION

**LAND CORNER RECORDATION CERTIFICATE**  
Filing Requirement of Act 74, Mich. P.A. 1970

For corners in

Ogemaw (County)	Located In:	Corner Code #
1. Public Land Survey	T 22N R 4E	B - 13
	T R	
	T R	
	T R	
2. Property Controlling in Section	S T R	
	S T R	
3. Miscellaneous Property in Sec.	S T R	
	S T R	

STATE OF MICHIGAN  
OGEMAW COUNTY  
RECORDED

30 DEC 96 4:32 P.M.

WANDA MUZIK  
REGISTER OF DEEDS

Register of Deeds Stamp & File Number

4. Lot No. \_\_\_\_\_, Recorded Plat \_\_\_\_\_  
5. Private Claims \_\_\_\_\_

I, Timothy L. Lapham, in a field survey on December, 19 96 do hereby state that under requirements of P.A. 74, Michigan P.A. of 1970, the corner points mentioned in lines 1 and 2 above were in conformance with regulations and rules therefore as required in the current manual of survey instructions of the United States Department of the Interior, Bureau of Land Management or by a decree of a Court of Law and for that the corner points mentioned in lines 3, 4 and 5 above were in conformance with the rules of the Michigan Board of Land Surveyors or by a Decree of a Court of Law, established, re-established, monumented, recovered, found as expressed below:

NOTE: Not more than 2 corners, all in the same town and range, may be recorded on this certificate.

	A	B	C	D	E	F	G	H	I	J	K	L	M
1													
2		6		5		4		3		2		1	
3													
4		7		8		9		10		11		12	
5													
6		18		17		16		15		14		13	
7													
8		19		20		21		22		23		24	
9													
10		30		29		28		27		26		25	
11													
12		31		32		33		34		35		36	
13													

East 110' iron rod

A. Description of original monument and accessories and/or subsequent restoration:

GLO, L. Clason	Shows monument N0-30E 118.8'
Set Post	LCRC, Lapham 10/9/85 (Rec L1, P326)
Aspen 7" N44E 9 links	1-1/2" pipe
W. Birch 14" N01W 36 links	South 1.2' waters edge
Survey, Henning 8/21/41	N45E 34.20 16" Oak
Note that 1/4 post as set is 18' east of lakeshore	East 32.29' 10" Oak
Plat, Hook 9/3/81, Supervisors Plat of Moffat's	S85E 53.13' 8" Ash
Subdivision	LCRC Ledy 8/16/89 (Rec L2, P85)
Rec L3, P53	Found 1-1/2" pipe in Lake
No corner material	North 1' to shoreline
	North 119.67' Conc Mon


B. Description of corner evidence found and/or method applied in restoring or reestablishing corner:

No evidence of GLO corner found. No corner found at corner position. Found Meander corner West of corner. Reset corner based on pro-rated position according to Henning survey on township line between MC and C-13. Accepted as a faithful re-establishment of the corner position. See dossier for additional information.

APPROVED BY  
PEER REVIEW  
*12-18-96 TW*  
DATE 12-18-96 P.A. 345 of 1990

C. Description of monument for corner and accessories established to perpetuate locating the position of the corner:

Set 5/8"X36" re-rod with 2-1/4" Aluminum cap Marked "1996 27595"  
From Which:  
N52E 23.37' 15" Oak  
S63E 37.19' 12" Ash  
West 16.42' 5/8" capped rerod Meander Corner  
N52W 52.39' 6" Cedar  
Monument located 15' North of water's edge  
Waters edge

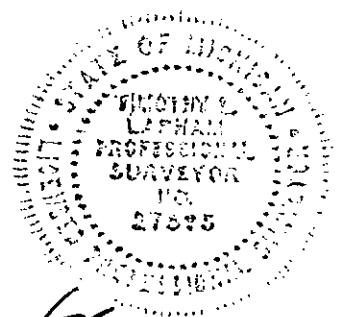

Signed by *Timothy L. Lapham*  
Surveyor's Michigan License No. 27595

Date 12/27/96