

MAY 28 1997

OGEMAW COUNTY REMONUMENTATION

COMMISSION

LAND CORNER RECORDATION CERTIFICATE
Filing Requirement of Act 74, Mich. P.A. 1970

For corners in

Ogemaw (County)	Located In:	Corner Code #
1. Public Land Survey	T 22N R 4E	D - 13
	T R	
	T R	
	T R	
2. Property Controlling in Section	S T R	
	S T R	
3. Miscellaneous Property in Sec.	S T R	
	S T R	

STATE OF MICHIGAN
OGEMAW COUNTY
RECORDED

30 DEC 96 4:32 P.M.

WANDA MUZIK
REGISTER OF DEEDS

Register of Deeds Stamp & File Number

4. Lot No. _____, Recorded Plat _____
5. Private Claims _____

I, Timothy L. Lapham, in a field survey on December, 19 96 do hereby state that under requirements of P.A. 74, Michigan P.A. of 1970, the corner points mentioned in lines 1 and 2 above were in conformance with regulations and rules therefore as required in the current manual of survey instructions of the United States Department of the Interior, Bureau of Land Management or by a decree of a Court of Law and/or that the corner points mentioned in lines 3, 4 and 5 above were in conformance with the rules of the Michigan Board of Land Surveyors or by a Decree of a Court of Law; established, re-established, monumented, recovered, found as expressed below:

	A	B	C	D	E	F	G	H	I	J	K	L	M
1													
2	6		5		4		3		2		1		
3													
4	7		8		9		10		11		12		
5													
6	18		17		16		15		14		13		
7													
8	19		20		21		22		23		24		
9													
10	30		29		28		27		26		25		
11													
12	31		32		33		34		35		36		
13													

NOTE: Not more than 2 corners, all in the same town and range, may be recorded on this certificate.


A. Description of original monument and accessories and/or subsequent restoration:
GLO L. Clason, 1838
Set Post
B. Ash 12" N34E 22 links
Hemlock 12" N42W 22 links
No subsequent survey information available.

B. Description of corner evidence found and/or method applied in restoring or reestablishing corner:
No evidence of GLO corner found. Set corner at GLO proportionate distance on line between C13 and E13.

APPROVED BY
PEER REVIEW
12-18-96
DATE P.A. 345 of 1990

C. Description of monument for corner and accessories established to perpetuate locating the position of the corner:

Set 5/8" X 3/8" re-rod with 2-1/4" Aluminum cap Marked "1996 27595"
From Which:
S14E 62.01' 20" Ash
S38W 36.35' 8" Apple
N83W 40.03' 5/8" capped rerod D-1 T21N R4E
N28W 81.42' Utility Pole
East 12' Centerline Middleton Road
South 2' Centerline Hardwood Hleghts Road.

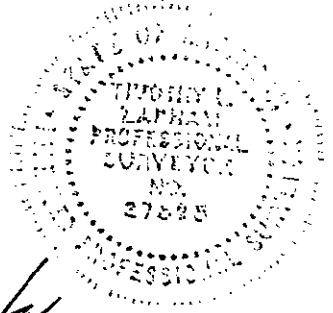

Signed by [Signature]
Surveyor's Michigan License No. 27595

Date 12/27/96