

MAY 28 1997

OGEMAW COUNTY REMONUMENTATION

LIBER 3 PAGE 98

COMMISSION

LAND CORNER RECORDATION CERTIFICATE
Filing Requirement of Act 74, Mich. P.A. 1970

For corners in

Table with columns: Ogemaw (County), Located In, Corner Code #. Includes entries for Public Land Survey, Property Controlling in Section, and Miscellaneous Property in Sec.

STATE OF MICHIGAN
OGEMAW COUNTY
RECORDED
30 DEC 96 4:33 P.M.
WANDA MUZIK
REGISTER OF DEEDS
Register of Deeds Stamp & File Number

4. Lot No. Recorded Plat
5. Private Claims

I, Timothy L. Lapham, in a field survey on December 19 96 do hereby state that under requirements of P.A. 74, Michigan P.A. of 1970, the corner points mentioned in lines 1 and 2 above were in conformance with regulations and rules therefore as required in the current manual of survey instructions of the United States Department of the Interior, Bureau of Land Management or by a decree of a Court of Law and/or that the corner points mentioned in lines 3, 4 and 5 above were in conformance with the rules of the Michigan Board of Land Surveyors or by a Decree of a Court of Law, established, re-established, monumented, recovered, found as expressed below.

NOTE: Not more than 2 corners, all in the same town and range, may be recorded on this certificate.

Grid table with columns A-L and rows 1-13. A dot is marked at the intersection of column G and row 13.

A. Description of original monument and accessories and/or subsequent restoration:

- GLO, L. Clason, 1838
Set post
W. Pine 14" N17E 22 links
B. Ash 8" N48W 36 links
LCRC, Act 313 (Rec 9/27/77, L1, P186)
Set 3/4" Pipe alongside 4x4 stake
N35W 57.82' Power Pole
S55W 41.71' Fe. Post
N80E 51.49' Fe. Post


B. Description of corner evidence found and/or method applied in restoring or reestablishing corner:

No evidence of GLO found. Found 3/4" pipe at road North-South & West. Found NW power pole and SW fe. post remains of recorded LCRC. Accepted found corner as best evidence of the position of the original corner. See dossier for additional information.

APPROVED BY
PEER REVIEW
12-18-96 JLL
DATE P.A. 345 of 1990

C. Description of monument for corner and accessories established to perpetuate locating the position of the corner:

- Set 5/8" X36" re-rod with 2-1/4" Aluminum cap marked "1896 27595"
From Which:
S89E 37.04' Fence Corner post
S22E 70.36' Fence Post
West 30.39' 5/8" capped rerod G-1 T21N R4E
N28W 57.15' Utility Pole
East 3' Centerline Clark Road.

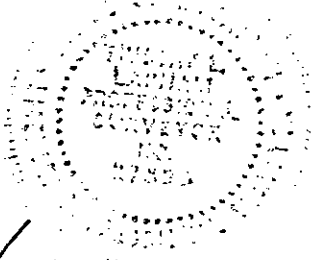

Signed by [Signature]
Surveyor's Michigan License No. 27595

Date 12/27/96