

LAND CORNER RECORDATION CERTIFICATE

FILING REQUIREMENT OF ACT 74, MICH. P.A.1970

FOR CORNERS OF--	LOCATED IN--	CORNER CODE NUMBER
1. PUBLIC LAND SURVEY	T. 23 N. R. 1 E.	G-5; G-6; G-7
2. PROPERTY CONTROLLING IN SECTION	T. S. R. W.	
3. MISCELLANEOUS PROPERTY IN SECTION	T. S. R. W.	
4. LOT NO. _____, RECORDED PLAT _____		
5. PRIVATE CLAIMS _____		

REGISTER OF DEEDS STAMP AND FILING NUMBER

I, KENNETH J. OSTLING, do hereby certify that under requirements of P.A. 74, Michigan P.A. of 1970, the corner points mentioned in lines 1 and 2 above were, in a field survey on AUGUST 27, 1981, established, re-established, monumented, re-monumented, recovered or restored as expressed below and in conformance with regulations and rules therefore as required in the current manual of survey instructions of the United States Department of the Interior, Bureau of Land Management or by a decree of a court of law. Furthermore, that the corner points mentioned in lines 3, 4 and 5 above were, in a field survey on _____, 19____, found, recovered, restored, established or re-established as expressed below and in conformance with the rules of the Michigan State Board of Registration for Land Surveyors or, by a Decree of a Court of law:

XX

G-7
 LEFT 1/2" ROD IN PLACE
 ::12" J. PINE (DEAD) N13°E 5.0'
 ::12" J. PINE (DEAD) S4°W 20.7'
 10" J. PINE S41°E 12.0'
 6" J. PINE S87°W 14.6'
 :: OLD NBTS - RICHARDSON

B. Description of corner evidence found and/or method applied in restoring or re-establishing corner:


- G-5 FOUND 1/2" BAR AS RESTORED IN A PREVIOUS SURVEY BY J. RICHARDSON, R.L.S. APPARENTLY USED IN SECTION 10 SURVEY.
- G-6 FOUND 1/2" BAR AS RESTORED IN A PREVIOUS SURVEY BY J. RICHARDSON, R.L.S. BEST AVAILABLE EVIDENCE.
- G-7 FOUND 1/2" BAR AS RESTORED IN A PREVIOUS SURVEY BY J. RICHARDSON, R.L.S.

C. Description of monument for corner and accessories established to perpetuate locating the position of the corner:

G-5
 LEFT 1/2" ROD IN PLACE
 ::12" J. PINE S45°W 40.9'
 ::12" J. PINE N45°W 20.5'
 :: 8" J. PINE (DEAD) N51°E 39.7'
 12" J. PINE S36°E 19.4'
 5" J. PINE N44°E 14.8'
 :: OLD NBTS - RICHARDSON

G-6
 LEFT 1/2" ROD IN PLACE
 :: 9" J. PINE N9°E 20.4'
 :: 9" R. OAK S80°W 10.8'
 12" OAK S35°E 35.4'
 5" J. PINE N30°W 12.2'
 :: OLD NBTS - RICHARDSON

SIGNED BY *Kenneth Ostling* DATE 3-8
 SURVEYOR'S MICHIGAN REGISTRATION NO. 10068

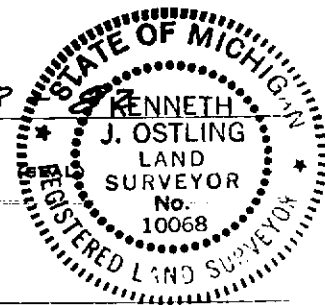

FOR STATE AND UNITED STATES AGENCIES:
 SIGNED BY _____ DATE _____
 CHIEF OF SURVEY PARTY
 APPROVED AND SIGNED BY _____ DATE _____
 MICHIGAN REGISTERED LAND SURVEYOR (SEAL)

SURVEYOR'S MICHIGAN REGISTRATION NO. _____ OGEMAW COUNTY