

LAND CORNER RECORDATION CERTIFICATE

Filing Requirement of Act 74, Mich. PA 1970

For Corners In:
Ogemaw Located In _____ Corner Code # _____
 (County)

1. Public Land Survey T 23 N R 1 E M-11
 T 23 N R 1 E M-10

2. Property Controlling in Section S _____ T _____ R _____
 S _____ T _____ R _____


3. Miscellaneous Property in Section S _____ T _____ R _____
 S _____ T _____ R _____

4. Lot No: _____ Recorded Plat: _____

5. Private Claims: _____

I, Carl T. Kiiskila, in a field survey on July 6, 2000 do hereby state that under requirements of PA 74, Michigan PA of 1970, the corner points mentioned in lines 1 and 2 above were in conformance with regulations and rules therefore as required in the current manual of survey instructions of the United States Department of the Interior, Bureau of Land Management or by a decree of a Court of Law and/or that the corner points mentioned in lines 3, 4 and 5 above were in conformance with the rules of the Michigan Board of Land Surveyors or by a Decree of a Court of Law, established, re-established, monumented, recovered, found as expressed below:

NOTE: Not more than 2 corners, all in the same town and range, may be recorded on this certificate.

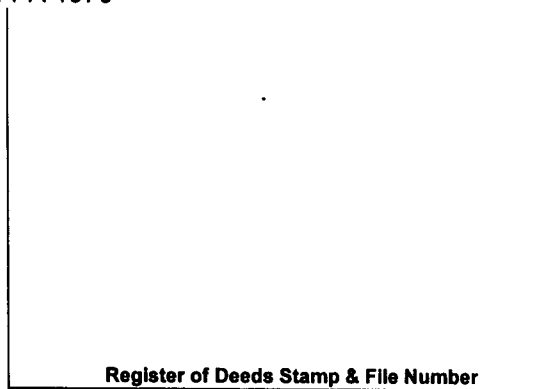

	A	B	C	D	E	F	G	H	I	J	K	L	M
1													
2	6		8		4		3		2		1		
3													
4	7		8		9		10		11		12		
5													
6	18		17		16		15		14		13		
7													
8	19		20		21		22		23		24		
9													
10	30		29		28		27		26		25		
11													
12	31		32		33		34		35		36		
13													

A. Description of original monument and accessories and/or subsequent restoration:

M-11 GLO Lewis Clawson D.S. 1838
 Set section post corner section 25 and 36
 Wit: Yellow Pine 12 S56°W 23 Links
 White Pine 12 N14°W 53 Links

M-10 GLO Lewis Clawson D.S. 1838
 Set quarter section post
 Wit: Dry Pine stub N58E 40 Links
 No other witness convenient

Liber 7, Page 20, John P. May P.S. #43061, found iron for corner
 Wit: S06°E 32.64' 8" Red Pine
 S64°W 71.31' 12" Oak
 N59°W 62.78' R.O.W. monument
 N35°E 39.36' 8" Pin Oak

Larry Cavanagh RLS#17614 February 1974 certificate of survey for Great Oak Estate. Found 1" pinch pipe for corner.

B. Description of corner evidence found and/or method applies in restoring or re-establishing corner:

M-11 Found 1/2" iron rod

M-10 Found 1" pinched iron pipe

C. Description of monument for corner and accessories established to perpetuate locating the position of the corner:

M-11 1/2" iron rod added monument box
 Wit: 9" Oak N42°E 38.38'
 * 8" Red Pine S10°E 32.61'
 4" Oak S39°W 44.72'
 * Fence Corner Post North 30.79'
 † E-W blacktop road South 1'±
 * Old witness by others

M-10 1" pinched iron pipe
 Wit: * 8" Jackpine S85°E 31.49'
 7" Cherry N56°E 45.90'
 * Fence Corner Post N30°W 1.83'
 7" Cherry S36°E 41.46'
 * 6" Twin Cherry N15°W 36.71'
 † N-S trail road East 12'±
 Carsonite Post North 1'±
 * Old witness by others

Signed by: Carl T. Kiiskila
 Surveyor's Michigan License No.: 33981

Date: 12-4-00

