

LAND CORNER RECORDATION CERTIFICATE


Filing Requirement of Act 74, Mich. PA 1970

For Corners In: <u>Ogemaw</u> (County)	Located In	Corner Code #	
1. Public Land Survey	T <u>23 N</u> R <u>1 E</u>	<u>M-9</u>	
	T <u>23 N</u> R <u>1 E</u>	<u>L-9</u>	
2. Property Controlling in Section	S _____ T _____ R _____	_____	
	S _____ T _____ R _____	_____	
3. Miscellaneous Property in Section	S _____ T _____ R _____	_____	
	S _____ T _____ R _____	_____	
4. Lot No: _____	Recorded Plat: _____		
5. Private Claims: _____			

Register of Deeds Stamp & File Number

I, Carl T. Kiiskila, in a field survey on July 3, 2000 do hereby state that under requirements of PA 74, Michigan PA of 1970, the corner points mentioned in lines 1 and 2 above were in conformance with regulations and rules therefore as required in the current manual of survey instructions of the United States Department of the Interior, Bureau of Land Management or by a decree of a Court of Law and/or that the corner points mentioned in lines 3, 4 and 5 above were in conformance with the rules of the Michigan Board of Land Surveyors or by a Decree of a Court of Law; established, re-established, monumented, recovered, found as expressed below:

NOTE: Not more than 2 corners, all in the same town and range, may be recorded on this certificate.

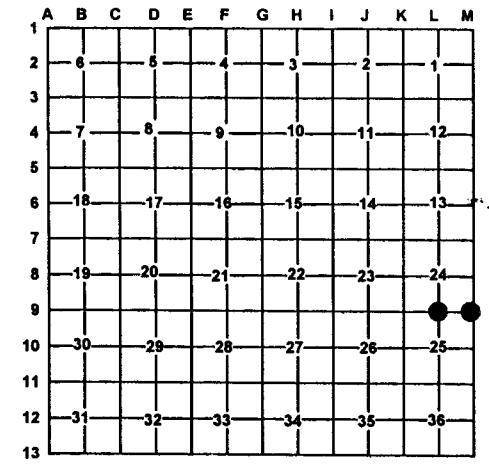

A. Description of original monument and accessories and/or subsequent restoration:

M-9 GLO Lewis Clawson D.S. 1838.
 Set section post corner 24 & 25
 Wit: White Pine 16" S32°W 18 Links
 White Pine 24" N58°W 24 Links

L-9 GLO James H. Mullett D.S. 1846.
 Set quarter section post
 Wit: Beech 10" S40°E 37 Links
 Beech 6" S21°W 16 Links

Marcus Schaaf RLS #3104, set pipe, no witnesses or date given

Liber 1, Page 340, Larry Cavanagh RLS #17614 Re-established the North 1/4 corner of section 25 by single proportionate measurement.

Liber 1, Page 512, Larry Cavanagh RLS #17514, Nov. 1973
 Found 1 1/4" pipe in concrete for corner.
 Wit: 18" Oak N34°E 65.0'
 14" W. Oak S25°E 55.1'
 10" W. Oak S29°W 42.2'

Wit: 6" Oak N14°W 20.1'
 5" Oak N45°E 35.07'

B. Description of corner evidence found and/or method applies in restoring or re-establishing corner:

M-9 Found 1 1/4" Iron pipe in concrete.

L-9 Re-established the North quarter corner of section 25 midway and on line between corners K-9 and M-9.

C. Description of monument for corner and accessories established to perpetuate locating the position of the corner:

M-9 1 1/4" Iron pipe
 Wit: * 14" Oak N15°W 43.20'
 * 18" Oak S54°W 18.65'
 * Fence Corner Post S05°W 33.27'
 * 8" White Pine S35°E 53.84'
 Carsonite Post North 1'±
 E-W Trail Road North 16'±

L-9 5/8" X 32" reroed with PS cap #33981
 Wit: 10" Oak N16°W 26.72'
 8" Oak N35°E 39.34'
 10" Oak S47°E 28.95'
 2" Cherry S46°W 26.69'
 Carsonite Post North 33'±
 E-W Trail Road North 2'±

* Old witness by others

Signed by: Carl T. Kiiskila
 Surveyor's Michigan License No.: 33981

Date: 12-4-00

