

LAND CORNER RECORDATION CERTIFICATE

Filing Requirement of Act 74, Mich. PA 1970

For Corners In: Ogemaw (County)	Located In	Corner Code #
1. Public Land Survey	T _____ R _____	_____
2. Property Controlling in Section	S <u>25</u> T <u>23 N</u> R <u>1 E</u>	<u>7</u>
3. Miscellaneous Property in Section	S _____ T _____ R _____	_____
	S _____ T _____ R _____	_____

4. Lot No: _____ Recorded Plat: _____

5. Private Claims: _____

I, Carl T. Kiiskila, in a field survey on January 1, 2001 do hereby state that under requirements of PA 74, Michigan PA of 1970, the corner points mentioned in lines 1 and 2 above were in conformance with regulations and rules therefore as required in the current manual of survey instructions of the United States Department of the Interior, Bureau of Land Management or by a decree of a Court of Law and/or that the corner points mentioned in lines 3, 4 and 5 above were in conformance with the rules of the Michigan Board of Land Surveyors or by a Decree of a Court of Law; established, re-established, monumented, recovered, found as expressed below:

NOTE: Not more than 2 corners, all in the same town and range, may be recorded on this certificate.

Register of Deeds Stamp & File Number

	A	B	C	D	E	F	G	H	I	J	K	L	M
1													
2	6	5	4	3	2	1							
3													
4	7	8	9	10	11	12							
5													
6	18	17	16	15	14	13							
7													
8	19	20	21	22	23	24							
9													
10	30	29	28	27	26	25							
11													
12	31	32	33	34	35	36							
13													

A. Description of original monument and accessories and/or subsequent restoration:


7- In July of 2000 I Carl Kiiskila P.S. #33981 set the north 1/16 on the East line of section 25 T.23N.,R.1E. recorded in Liber 4, page 95. In December of 2000 John May P.S. #43061 brought to my attention that the corner I had set did not conform to the information I had provided him. After reviewing my field notes and calculations I determined that I had set the corner 2.69 feet east of its proper position. On January 29, 2001 I relocated the 5/8" X 32" rered to its intended location 2.69 feet to the west along side of a 1/2" capped iron previously set by Larry Cavanagh R.L.S. #17614.

B. Description of corner evidence found and/or method applies in restoring or re-establishing corner:

7 - Established the North 1/16 corner on the East line of Section 25 per BLM instructions for the subdivision of a section.

C. Description of monument for corner and accessories established to perpetuate locating the position of the corner:

7 -Set 5/8" X 32" rered with P.S. cap #33981
 Wit: 5" Maple S09°W 7.40'
 5" Maple N76°W 9.29'
 5" Maple N43°E 42.14'
 4" W. Oak S63°E 17.63'
 Carsonite post North 1'±

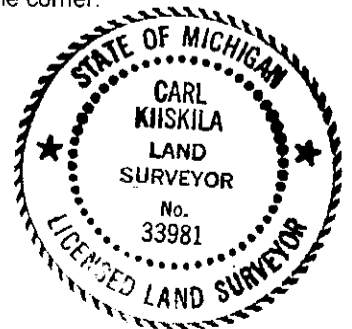

Signed by: Carl T Kiiskila
 Surveyor's Michigan License No.: 33981

Date: 3-9-03