

LAND CORNER RECORDATION CERTIFICATE

FILING REQUIREMENT OF ACT 74, MICH. P.A.1970

Agemaw

FOR CORNERS OF--	LOCATED IN--	CORNER CODE NUMBER
1. PUBLIC LAND SURVEY _____	T. <u>23</u> N. <u>•</u> , R. <u>2</u> E. <u>•</u>	<u>G-5; G-6; G-7</u>
2. PROPERTY CONTROLLING IN SECTION <u>16</u>	T. <u>23</u> N. <u>•</u> , R. <u>2</u> E. <u>•</u>	<u>9</u>
3. MISCELLANEOUS PROPERTY IN SECTION _____	T. _____ N. _____, R. _____ E. _____	_____
4. LOT NO. _____, RECORDED PLAT _____		
5. PRIVATE CLAIMS _____		

REGISTER OF DEEDS STAMP AND FILING NUMBER

I, Kenneth J. Ostling do hereby certify that under requirements of P.A. 74, Michigan P.A. of 1970, the corner points mentioned in lines 1 and 2 above (identified with circles on index code diagram - over) were, in a field survey on June 28, 1973, established, re-established, monumented, re-monumented, recovered or restored as expressed below and in conformance with regulations and rules therefore as required in the current manual of survey instructions of the United States Department of the Interior, Bureau of Land Management or by a decree of a court of law. Furthermore, that the corner points mentioned in lines 3, 4 and 5 above were, in a field survey on _____ 19____, found, recovered, restored, established or re-established as expressed below and in conformance with the rules of the Michigan State Board of Registration for Land Surveyors or, by a Decree of a Court of law:


A. Description of original monument and accessories and/or subsequent restoration:

- B. Description of corner evidence found and/or method applied in restoring or re-establishing corner:
- G-5 Found 1/2" iron bar as established in 1956 survey by R. T. Ostling of Section 10. Fits old road south.
 - G-6 Set corner in line with fence line east, at average center of old N-S corduroy road, through marsh. Best available evidence.
 - G-7 Found 1/2" x 3" iron bar at corner as established in previous survey. Fits roads east and north.
 - 9 Set by standard survey procedure for subdivision of sections.

- C. Description of monument for corner and accessories established to perpetuate locating the position of the corner:
- | | | |
|--|--|--|
| G-5 | G-6 | G-7 |
| Set DNR Mon.
19" W. Pine N75°W 42.6'
6" R. Oak S38°W 43.1'
Red Top Post | Set DNR Mon.
10" W. Pine N60°W 12.3'
16" W. Pine N40°E 21.3'
Red Top Post | Set DNR Mon.
17" W. Oak S70°E 43.4'
5" Maple S57°W 26.8' |
| 9 | | |
| Set 1" x 24" Pipe
10" R. Oak N58°E 14.8'
9" W. Oak N10°E 48.2' | | |

SIGNED BY Kenneth J. Ostling SURVEYOR'S MICHIGAN REGISTRATION NO. 10068

DATE 8/18/73

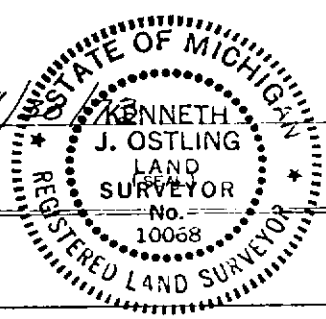

FOR STATE AND UNITED STATES AGENCIES:

SIGNED BY _____ DATE _____
CHIEF OF SURVEY PARTY

APPROVED AND SIGNED BY _____ DATE _____
MICHIGAN REGISTERED LAND SURVEYOR (SEAL)

SURVEYOR'S MICHIGAN REGISTRATION NO. _____