

LAND CORNER RECORDATION CERTIFICATE

FILING REQUIREMENT OF ACT 74, MICH. P.A.1970

Ostling

| FOR CORNERS OF--: | LOCATED IN--: | CORNER CODE NUMBER |
|--|---|--------------------|
| 1. PUBLIC LAND SURVEY _____ | T. <u>23</u> N. <u>2</u> E. <u>●</u> S. <u>●</u> , R. <u>2</u> E. <u>●</u> | <u>E-5; F-5</u> |
| 2. PROPERTY CONTROLLING IN SECTION <u>16</u> | T. <u>23</u> N. <u>2</u> E. <u>●</u> S. <u>●</u> , R. <u>2</u> E. <u>●</u> | <u>1; 2</u> |
| 3. MISCELLANEOUS PROPERTY IN SECTION _____ | T. _____ N. _____ E. _____ S. _____, R. _____ W. _____ | _____ |
| 4. LOT NO. _____, RECORDED PLAT _____ | | |
| 5. PRIVATE CLAIMS _____ | | |

REGISTER OF DEEDS STAMP AND FILING NUMBER

I, Kenneth J. Ostling do hereby certify that under requirements of P.A. 74, Michigan P.A. of 1970, the corner points mentioned in lines 1 and 2 above (identified with circles on index code diagram—over) were, in a field survey on May 17, 1973, established, re-established, monumented, re-monumented, recovered or restored as expressed below and in conformance with regulations and rules therefore as required in the current manual of survey instructions of the United States Department of the Interior, Bureau of Land Management or by a decree of a court of law. Furthermore, that the corner points mentioned in lines 3, 4 and 5 above were, in a field survey on _____ 19____, found, recovered, restored, established or re-established as expressed below and in conformance with the rules of the Michigan State Board of Registration for Land Surveyors or, by a Decree of a Court of law:

A. Description of original monument and accessories and/or subsequent restoration:

B. Description of corner evidence found and/or method applied in restoring or re-establishing corner:

- E-5 Found 2" pipe in concrete buried at intersection, possibly set in Marcus Schaaf survey. Best available evidence.
- F-5 Set by proportionate measurement between section corners.
 - 1 Set by standard survey procedure for the subdivision of sections.
 - 2 Set by standard survey procedure for the subdivision of sections.

C. Description of monument for corner and accessories established to perpetuate locating the position of the corner:

| E-5 | F-5 |
|------------------------|------------------------|
| Set DNR Monument | Set DNR Monument |
| 20" W. Oak N48°W 36.3' | 6" Maple S58°E 9.1' |
| 16" W. Oak N18°W 36.7' | 14" W. Oak N10°E 23.7' |
| 10" B. Oak N52°E 46.6' | |
| | |
| 1 | 2 |
| Set 1" x 30" Pipe | Set 1" x 30" Pipe |
| 10" Oak S40°E 34.9' | 9" R. Oak S65°W 43.9' |
| 3" W. Pine N87°E 31.8' | 8" R. Oak S16°E 46.1' |
| | Red Top Post |


SIGNED BY *Kenneth J. Ostling* DATE 8/30

SURVEYOR'S MICHIGAN REGISTRATION NO. 10068

FOR STATE AND UNITED STATES AGENCIES:

SIGNED BY _____ DATE _____
CHIEF OF SURVEY PARTY

APPROVED AND SIGNED BY _____ DATE _____
MICHIGAN REGISTERED LAND SURVEYOR

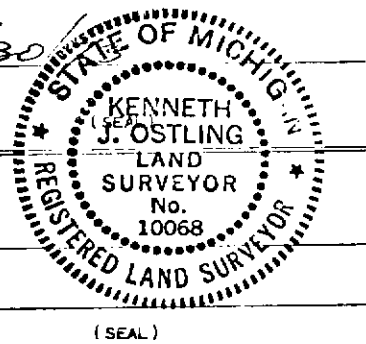

SURVEYOR'S MICHIGAN REGISTRATION NO. _____