

LAND CORNER RECORDATION CERTIFICATE

FILING REQUIREMENT OF ACT 74, MICH. P.A.1970

| FOR CORNERS OF--: | LOCATED IN--: | CORNER CODE NUMBER |
|--|---|-------------------------|
| 1. PUBLIC LAND SURVEY _____ | T. <u>23</u> N. <input checked="" type="radio"/> , R. <u>2</u> E. <input checked="" type="radio"/> | <u>E-11; F-11; H-11</u> |
| 2. PROPERTY CONTROLLING IN SECTION _____ | T. _____ N. <input type="radio"/> , S. <input type="radio"/> , R. _____ E. <input type="radio"/> , W. <input type="radio"/> | _____ |
| 3. MISCELLANEOUS PROPERTY IN SECTION _____ | T. _____ N. <input type="radio"/> , S. <input type="radio"/> , R. _____ E. <input type="radio"/> , W. <input type="radio"/> | _____ |
| 4. LOT NO. _____, RECORDED PLAT _____ | | |
| 5. PRIVATE CLAIMS _____ | | |

REGISTER OF DEEDS STAMP AND FILING NUMBER

I, Kenneth J. Ostling, do hereby certify that under requirements of P.A. 74, Michigan P.A. of 1970, the corner points mentioned in lines 1 and 2 above were, in a field survey on June 6, 1978, established, re-established, monumented, re-monumented, recovered or restored as expressed below and in conformance with regulations and rules therefore as required in the current manual of survey instructions of the United States Department of the Interior, Bureau of Land Management or by a decree of a court of law. Furthermore, that the corner points mentioned in lines 3, 4 and 5 above were, in a field survey on _____, 19____, found, recovered, restored, established or re-established as expressed below and in conformance with the rules of the Michigan State Board of Registration for Land Surveyors or, by a Decree of a Court of law:

A. Description of original monument and accessories and/or subsequent restoration:


- B. Description of corner evidence found and/or method applied in restoring or re-establishing corner:
- E-11 Found 3/4" bar at corner in road intersection.
 - F-11 Set corner in very old N-S fence line, on line between section corners.
 - H-11 Found 3/4" pipe at corner, set from U.S.B.T. stump in place with good face.

C. Description of monument for corner and accessories established to perpetuate locating the position of the corner:

| E-11 | F-11 | H-11 |
|--|-----------------------------|------------------------------------|
| Set DNR mon. in place of 3/4" iron bar | Set DNR mon. & red-top post | Set DNR mon. in place of 3/4" pipe |
| 10" Maple N33°W 31.8 | 8" R. Pine S45°E 26.2 | 20" R. Pine N55°W 32.9 |
| 8" Maple S48°W 48.75 | 4" R. Pine S35°W 48.5 | 6" Balsam N15°E 20.3 |
| | | Pine Stump OBT S84°E 17.3 |

SIGNED BY *Kenneth J. Ostling*
 SURVEYOR'S MICHIGAN REGISTRATION NO. 10068

DATE 8/24/78

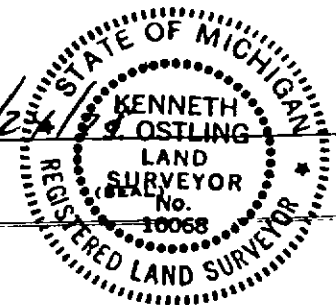

FOR STATE AND UNITED STATES AGENCIES:

SIGNED BY _____ DATE _____
CHIEF OF SURVEY PARTY

APPROVED AND SIGNED BY _____ DATE _____
MICHIGAN REGISTERED LAND SURVEYOR (SEAL)

SURVEYOR'S MICHIGAN REGISTRATION NO. _____ OGEMAW COUNTY