

LAND CORNER RECORDATION CERTIFICATE

FILING REQUIREMENT OF ACT 74, MICH. P.A.1970

FOR CORNERS OF--:	LOCATED IN--:	CORNER CODE NUMBER
1. PUBLIC LAND SURVEY	T. 23 N. R. 2 E.	A-2; B-2; C-2
2. PROPERTY CONTROLLING IN SECTION	6, T. 23 N. R. 2 E.	9
3. MISCELLANEOUS PROPERTY IN SECTION	T. S. R. W.	
4. LOT NO. _____, RECORDED PLAT _____		
5. PRIVATE CLAIMS _____		

REGISTER OF DEEDS STAMP AND FILING NUMBER

I, Kenneth J. Ostling, do hereby certify that under requirements of P.A. 74, Michigan P.A. of 1970, the corner points mentioned in lines 1 and 2 above were, in a field survey on June 12, 1980, established, re-established, monumented, re-monumented, recovered or restored as expressed below and in conformance with regulations and rules therefore as required in the current manual of survey instructions of the United States Department of the Interior, Bureau of Land Management or by a decree of a court of law. Furthermore, that the corner points mentioned in lines 3, 4 and 5 above were, in a field survey on _____, 19____, found, recovered, restored, established or re-established as expressed below and in conformance with the rules of the Michigan State Board of Registration for Land Surveyors or, by a Decree of a Court of law:

A. Description of original monument and accessories and/or subsequent restoration:

B. Description of corner evidence found and/or method applied in restoring or re-establishing corner:

- A-2 Found 1" pipe in road, with 2 old NBTs. Used in surveys in adjoining sections.
- B-2 Set corner by standard survey procedures at the intersection of the true ~~4~~ lines.
- C-2 Set corner by proportionate measurement between section corners. Could find no previous corner.
- 9 Set by standard survey procedure for the subdivision of sections.

C. Description of monument for corner and accessories established to perpetuate locating the position of the corner:

A-2	B-2	C-2
Left 1" pipe in place	Set 5/8" rod w/RLS cap	Set DNR Monument below surface
5" Maple N77°W 20.8'	5" J. Pine N32°E 13.0'	12" R. Pine N40°W 107.6'
6" maple S40°W 21.5'	5" J. Pine N82°E 17.9'	8" R. Pine N89°E 104.4'
N_S road East 3'		
		9
		Set 5/8" Rod w/RLS cap
		6" J. Pine N34°W 5.0'
		4" J. Pine N46°E 10.4'

SIGNED BY Kenneth Ostling

DATE 9/3/80

SURVEYOR'S MICHIGAN REGISTRATION NO. _____

FOR STATE AND UNITED STATES AGENCIES:

SIGNED BY _____


DATE _____

APPROVED AND SIGNED BY _____

DATE _____

MICHIGAN REGISTERED LAND SURVEYOR

(SEAL)

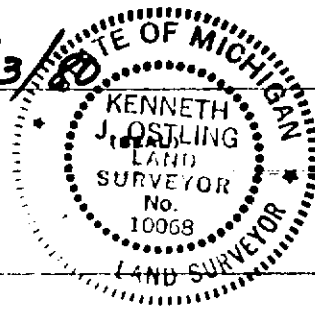

SURVEYOR'S MICHIGAN REGISTRATION NO. _____

M. Ogawa