

**LAND CORNER RECORDATION CERTIFICATE**  
**Filing Requirement of Act 74, Mich. P.A. 1970**

For corners in  
OGEMAW  
 (County)

Located In: \_\_\_\_\_ Corner Code # \_\_\_\_\_

- |                                    |   |             |           |          |
|------------------------------------|---|-------------|-----------|----------|
| 1. Public Land Survey              | T | <u>23NR</u> | <u>2E</u> | _____    |
|                                    | T | _____       | R         | _____    |
|                                    | T | _____       | R         | _____    |
|                                    | T | _____       | R         | _____    |
| 2. Property Controlling in Section | S | <u>21</u>   | T         | <u>R</u> |
|                                    | S | _____       | T         | R        |
| 3. Miscellaneous Property in Sec.  | S | _____       | T         | R        |
|                                    | S | _____       | T         | R        |

Register of Deeds Stamp & File Number

4. Lot No. \_\_\_\_\_, Recorded Plat \_\_\_\_\_  
 5. Private Claims \_\_\_\_\_

I, CARL R. JOHNSON, in a field survey on JUNE 13, 19 91, do hereby certify that under requirements of P.A. 74, Michigan P.A. of 1970, the corner points mentioned in lines 1 and 2 above were in conformance with regulations and rules therefore as required in the current manual of survey instructions of the United States Department of the Interior, Bureau of Land Management or by a decree of a Court of Law and/or that the corner points mentioned in lines 3, 4 and 5 above were in conformance with the rules of the Michigan Board of Land Surveyors or by a Decree of a Court of Law; established, re-established, monumented, re-monumented, recovered, found as expressed below:


**NOTE: Not more than 4 corners, all in the same town and range, may be recorded on this certificate.**

	A	B	C	D	E	F	G	H	I	J	K	L	M
2	6	5	4	3	2	1							
3													
4	7	8	9	10	11	12							
5													
6	18	17	16	15	14	13							
7													
8	19	20	21	22	23	24							
9													
10	30	29	28	27	26	25							
11													
12	31	32	33	34	35	36							
13													

A. Description of original monument and accessories and/or subsequent restoration:  
 14

B. Description of corner evidence found and/or method applied in restoring or reestablishing corner:  
 14  
 SET BY STANDARD PROCEDURE FOR  
 SUBDIVISION OF A SECTION.

C. Description of monument for corner and accessories established to perpetuate locating the position of the corner:  
 14  
 S. 1/8 COR. ON EAST LINE SEC.  
 21  
 5/8" BAR W/CAP  
  
 W. PINE 10" N42E 23.4 FT.  
 OAK 8" N23W 13.0 FT.  
 J. PINE 12" S16E 17.5 FT.  
 W. PINE 5" S22W 31.7 FT.

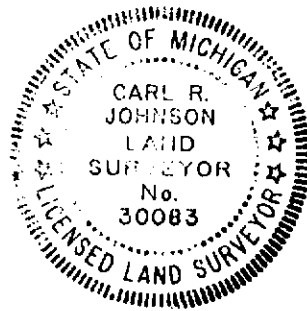

Signed by *Carl R. Johnson* Date 3/17/92  
 Surveyor's Michigan License No. 30083