

LAND CORNER RECORDATION CERTIFICATE

FILING REQUIREMENT OF ACT 74, MICH. P.A. 1970

FOR CORNERS OF--	LOCATED IN--	CORNER CODE NUMBER
1. PUBLIC LAND SURVEY _____	T. <u>23</u> N. S., R. <u>2</u> E.	<u>G-8; H-8; I-8</u>
2. PROPERTY CONTROLLING IN SECTION _____	T. _____ N. S., R. _____ E. W.	_____
3. MISCELLANEOUS PROPERTY IN SECTION _____	T. _____ N. S., R. _____ E. W.	_____
4. LOT NO. _____, RECORDED PLAT _____		
5. PRIVATE CLAIMS _____		

REGISTER OF DEEDS STAMP AND FILING NUMBER

I, KENNETH J. OSTLING, do hereby certify that under requirements of P.A. 74, Michigan P.A. of 1970, the corner points mentioned in lines 1 and 2 above were, in a field survey on JANUARY 20, 1983, established, re-established, monumented, re-monumented, recovered or restored as expressed below and in conformance with regulations and rules therefore as required in the current manual of survey instructions of the United States Department of the Interior, Bureau of Land Management or by a decree of a court of law. Furthermore, that the corner points mentioned in lines 3, 4 and 5 above were, in a field survey on _____, 19____, found, recovered, restored, established or re-established as expressed below and in conformance with the rules of the Michigan State Board of Registration for Land Surveyors or, by a Decree of a Court of law:

A. Description of original monument and accessories and/or subsequent restoration:


B. Description of corner evidence found and/or method applied in restoring or re-establishing corner:

- G-8 - SET CORNER BY PROPORTIONATE MEASUREMENT BETWEEN SECTION CORNERS. NEAR AVERAGE CENTERLINE OF N-S ROAD, AND APPROXIMATELY IN LINE WITH PARTS OF OLD FENCE LINE EAST.
- H-8 - SET CORNER BY STANDARD SURVEY PROCEDURE, AT CALCULATED INTERSECTION OF TRUE 1/4 LINES.
- I-8 - FOUND STEEL FENCE POST AT FENCE INTERSECTION N&E. LOCAL RESIDENT CLAIMS FENCE WAS IN PLACE AND ACCEPTED AS CORNER FOR 30+ YEARS, AND APPEARS TO FIT OCCUPATION IN BOTH SECTIONS.

C. Description of monument for corner and accessories established to perpetuate locating the position:

<u>G-8</u>		<u>H-8</u>
SET 5/8" ROD WITH RLS CAP		5/8" ROD WITH RLS CAP
16" RED OAK N32°E 46.8'		8" RED OAK N56°W 25.0'
12" WHITE OAK S52°W 25.3'		12" RED OAK S48°E 48.8'
		SET 4" CEDAR POST W/LOCATION TAG BY COR
	<u>I-8</u>	
	DNR MONUMENT	
	12" RED OAK N40°W 14.6'	
	12" JACK PINE S65°W 63.0'	

SIGNED BY Kenneth J. Ostling DATE 11-11-83
 SURVEYOR'S MICHIGAN REGISTRATION NO. 10068

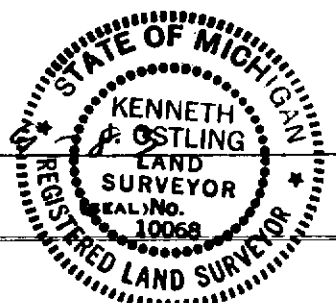

FOR STATE AND UNITED STATES AGENCIES:

SIGNED BY _____ DATE _____
CHIEF OF SURVEY PARTY
 APPROVED AND SIGNED BY _____ DATE _____
MICHIGAN REGISTERED LAND SURVEYOR

SURVEYOR'S MICHIGAN REGISTRATION NO. _____ OGEMAW COUNTY