

SURVEY & REMONUMENTATION

APR 29 1996

COMMISSION

LAND CORNER RECORDATION CERTIFICATE
Filing Requirement of Act 74, Mich. P.A. 1970

For corners in
Ogemaw
 (County)

Located In:

Corner Code #

- | | | | | |
|------------------------------------|---|-------------|-----------|------------|
| 1. Public Land Survey | T | <u>23NR</u> | <u>2E</u> | <u>I-1</u> |
| | T | _____ | R _____ | _____ |
| | T | _____ | R _____ | _____ |
| | T | _____ | R _____ | _____ |
| 2. Property Controlling In Section | S | _____ | T _____ | R _____ |
| | S | _____ | T _____ | R _____ |
| 3. Miscellaneous Property in Sec. | S | _____ | T _____ | R _____ |
| | S | _____ | T _____ | R _____ |

LIBER

3 PAGE **32**

STATE OF MICHIGAN
 OGEAW COUNTY
 RECORDED

28 DEC 95 3:22 P.M.

WANDA MIJIK
 REGISTER OF DEEDS

Register of Deeds Stamp & File Number

4. Lot No. _____, Recorded Plat _____
 5. Private Claims _____

	A	B	C	D	E	F	G	H	I	J	K	L	M
2	6		5		4		3		2		1		
3													
4	7		8		9		10		11		12		
5													
6	18		17		16		15		14		13		
7													
8	19		20		21		22		23		24		
9													
10	30		29		28		27		26		25		
11													
12	31		32		33		34		35		36		
13													

I, Timothy L. Lapham, in a field survey on December, 19 95, do hereby certify that under requirements of P.A. 74, Michigan P.A. of 1970, the corner points mentioned in lines 1 and 2 above were in conformance with regulations and rules therefore as required in the current manual of survey instructions of the United States Department of the Interior, Bureau of Land Management or by a decree of a Court of Law and/or that the corner points mentioned in lines 3, 4 and 5 above were in conformance with the rules of the Michigan Board of Land Surveyors or by a Decree of a Court of Law; established, re-established, monumented, re-monumented, recovered, found as expressed below:

NOTE: Not more than 4 corners, all in the same town and range, may be recorded on this certificate.

A. Description of original monument and accessories and/or subsequent restoration:

I-1: GLO Mullett 1846, Set Post, 12" Y. Pine S44E 45lnks, 14" W. Pine S44W 1.98ch; LCRC Lapham 2/2/89(Rec 2-67, 3/22/89), Found 1/2" Iron Bar, 4 Wits; Consumers Power Co. Survey 1967-8 Dorcey, Found corner, no wits or material


B. Description of corner evidence found and/or method applied in restoring or reestablishing corner:

I-1: No evidence of GLO survey found. Found 1/2" capped iron in accord with record LCRC. Corner is at record GLO distance West of Standard Corner and on Standard Line within acceptable tolerances. Distance to East is 4.65' short of C.P.Co. distance. Accepted found corner as best evidence of accepted position of corner. See dossier for additional information.

APPROVED BY
 PEER REVIEW
 12/20/95 *jm*
 DATE P.A. 345 of 1990

C. Description of monument for corner and accessories established to perpetuate locating the position of the corner:

I-1: Set 5/8"X36" rerod with 3-1/4" Aluminum Ogemaw Remon cap marked "27595 1995"
 From Which:
 N15E 71.58' iron
 N20E 88.24' 10" Twin Oak
 East 14.52' 5/8" Remon Monument
 South 0.85' Centerline Pavement
 S04W 49.84' Concrete Monument
 N50E 129.60' 8" Twin Oak

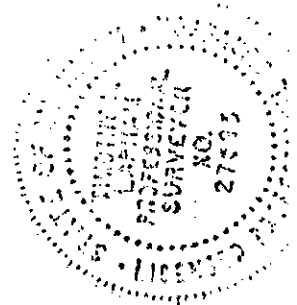

Signed by *[Signature]*

Date 12/28/95

Surveyor's Michigan License No. 27595