

**SURVEY &  
REMONUMENTATION**

APR 29 1996

**COMMISSION LAND CORNER RECORDATION CERTIFICATE**  
Filing Requirement of Act 74, Mich. P.A. 1970

For corners in  
Ogemaw

Located In:

Corner Code #/

(County)

- |                                       |   |     |   |    |     |
|---------------------------------------|---|-----|---|----|-----|
| 1. Public Land Survey                 | T | 23N | R | 2E | K-1 |
|                                       | T |     | R |    |     |
|                                       | T |     | R |    |     |
|                                       | T |     | R |    |     |
| 2. Property Controlling<br>In Section | S |     | T | R  |     |
|                                       | S |     | T | R  |     |
| 3. Miscellaneous<br>Property in Sec.  | S |     | T | R  |     |
|                                       | S |     | T | R  |     |

LIBER 3 PAGE 34

STATE OF MICHIGAN  
OGEMAW COUNTY  
RECORDED

28 DEC 95 3:23 P.M.

WANDA HUZIK  
REGISTER OF DEEDS

Register of Deeds Stamp & File Number

4. Lot No. \_\_\_\_\_, Recorded Plat \_\_\_\_\_  
5. Private Claims \_\_\_\_\_

	A	B	C	D	E	F	G	H	I	J	K	L	M
2	6		5		4		3		2				
3													
4	7		8		9		10		11		12		
5													
6	18		17		16		15		14		13		
7													
8	19		20		21		22		23		24		
9													
10	30		29		28		27		26		25		
11													
12	31		32		33		34		35		36		
13													

Timothy L. Lapham, In a field survey on December, 19 95

do hereby certify that under requirements of P.A. 74, Michigan P.A. of 1970, the corner points mentioned in lines 1 and 2 above were in conformance with regulations and rules therefore as required in the current manual of survey instructions of the United States Department of the Interior, Bureau of Land Management or by a decree of a Court of Law and/or that the corner points mentioned in lines 3, 4 and 5 above were in conformance with the rules of the Michigan Board of Land Surveyors or by a Decree of a Court of Law; established, re-established, monumented, re-monumented, recovered, found as expressed below:

**NOTE: Not more than 4 corners, all in the same town and range, may be recorded on this certificate.**

**A. Description of original monument and accessories and/or subsequent restoration:**

- K-1: GLO Mullett 1846 Set Post, 20" Beech S18W 27Lnks, 18" Sugar S11E, 18Lnks;  
Survey Caldwell 11/15/76(Rec 2-288, 6/17/77) No Cor Mat, No Wits;  
Survey Caldwell 11/20/80(Rec 3-271, 1/26/81), No Cor Mat, No Wits;  
Survey Ledy 7/7/88(Rec 4-227, 2/21/89), Found 1/2" Bar & Post, 3 Wits;  
LCRC Lapham 1/24/89(Rec 2-57, 3/22/89), Found LLS Capped Iron, 3 Wits;  
Survey Lapham 12/23/92(Rec 5-344), Reference LCRC 2-57;  
Survey Lapham 7/6/94(Rec 5-461), Reference LCRC 2-57;


**B. Description of corner evidence found and/or method applied in restoring or reestablishing corner:**

- K-1: No evidence of GLO found. Found 1/2" capped iron. Corner is in accord with all remaining evidence of record except witnesses on Survey 4-227 are all missing. Corner is 0.08 feet South of Standard Line at GLO offset from Standard corner. Accepted found corner as best evidence of accepted corner position. See dossier for additional information.

APPROVED BY  
PEER REVIEW  
12/11/95  
DATE P.A. 345 of 1990

**C. Description of monument for corner and accessories established to perpetuate locating the position of the corner:**

- K-1: Set 5/8"X36" rerod with 3-1/4" Aluminum Ogemaw Remon cap marked "27595 1995"  
From Which:  
N57E 99.60' 10" Apple w/spike  
East 18.42' 5/8" Remon Monument  
S31E 55.46' Spike in Light Pole  
S30W 144.64' 4" Elm w/spike

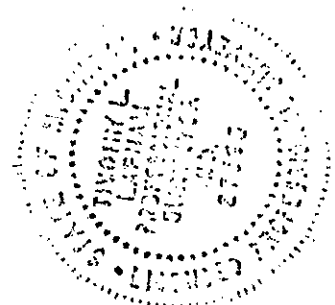

Signed by [Signature]  
Surveyor's Michigan License No. 27595

Date 12/28/95