

SURVEY & REMONUMENTATION

MAR 19 1998

OGEMAW COUNTY REMONUMENTATION

LAND CORNER RECORDATION CERTIFICATE
Filing Requirement of Act 74, Mich. P.A. 1970

For corners in **SECTION**

<u>Ogemaw</u> (County)	Located In:	Corner Code #
1. Public Land Survey	T <u>23N</u> R <u>2E</u>	<u>K-13</u>
	T _____ R _____	_____
	T _____ R _____	_____
	T _____ R _____	_____
2. Property Controlling in Section	S _____ T _____ R _____	_____
	S _____ T _____ R _____	_____
3. Miscellaneous Property in Sec.	S _____ T _____ R _____	_____
	S _____ T _____ R _____	_____

LIBER 3 PAGE 140
STATE OF MICHIGAN
OGEMAW COUNTY
RECORDED

26 Dec 1997 2:54:50 PM

WANDA MUZIK
REGISTER OF DEEDS

Register of Deeds Stamp & File Number

4. Lot No. _____, Recorded Plat _____
5. Private Claims _____

	A	B	C	D	E	F	G	H	I	J	K	L	I
1													
2	6			5				4				3	2
3													1
4	7			8				9				10	11
5													12
6	18			17				16				15	14
7													13
8	19			20				21				22	23
9													24
10	30			29				28				27	26
11													25
12	31			32				33				34	35
13													36

I, Timothy L. Lapham, in a field survey of December 11, 1997 do hereby state that under requirements of P.A. 74, Michigan P.A. of 1970, the corner points mentioned in lines 1 and 2 above were in conformance with regulations and rules therefore as required in the current manual of survey instructions of the United States Department of the Interior, Bureau of Land Management or by a decree of a Court of Law and/or that the corner points mentioned in lines 3, 4 and 5 above were in conformance with the rules of the Michigan Board of Land Surveyors or by a Decree of a Court of Law; established, re-established, monumented, recovered, found as expressed below:

NOTE: Not more than 2 corners, all in the same town and range, may be recorded on this certificate.

- A. Description of original monument and accessories and/or subsequent restoration:**
- GLO L. Clason 1838 set post
Cedar 12" N38E 38 Lk
Cedar 11' N31W 37 Lk
Closing cor intersects 19 Lk W of post
 - Higgins 1979 Survey (L3, P97)
Shows South line of Section 36
No corner or witnesses
 - 1976 Coldwell Survey (L2, P173)
Found bar and cap
West 12.5 P.K. nail (N cor Sec 1 & 2)
Section break with dist. N & W
 - Lapham 1995 LCRC (L3, P11)
Found 1/2" iron
N37E 566.66 utility pole
S18E 129.8 NW cor farm house
S43W 113.01 utility pole
West 12.50 1/2" iron
N44W 59.94 utility pole

- B. Description of corner evidence found and/or method applied in restoring or reestablishing corner:**
- No evidence of GLO corner. Stream South on closing corner approximately matches call. Coldwell 1976 survey matches found iron with distances to K-1, T22N, R2E, I-13, K-11, and K-12. Corner matches 1995 Lapham LCRC.

Accepted found iron as best evidence of correct corner position.


Approved by Peer Review

12-11-97 TL JLL
DATE INITIALS

- C. Description of monument for corner and accessories established to perpetuate locating the position of the corner:**

Set 5/8"x36" rerod with 3-1/4" Aluminum Ogemaw Remon cap marked "27595 1997"
N38E 56.60 utility pole
West 12.58 K-1, T22N, R2E
S48E 32.75 guard rail post
S15W 113.07 utility pole
N37W 59.90 utility pole
4' South of intersection centerline roads

Signed by [Signature]
Surveyor's Michigan License No. 27595

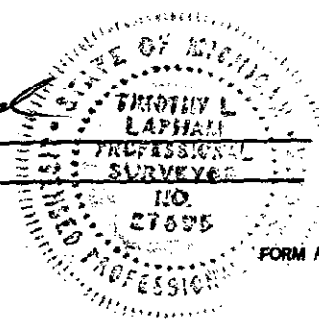

Date 12/24/97