

LAND CORNER RECORDATION CERTIFICATE

Filing Requirement of Act 74, Mich. PA 1970

For Corners In: Ogemaw (County)	Located In	Corner Code #
1. Public Land Survey	T <u>23N</u> R <u>2E</u>	<u>C-12</u>
	T <u>23N</u> R <u>2E</u>	<u>C-13</u>
2. Property Controlling in Section	S _____ T _____ R _____	_____
	S _____ T _____ R _____	_____
3. Miscellaneous Property in Section	S _____ T _____ R _____	_____
	S _____ T _____ R _____	_____


Register of Deeds Stamp & File Number

4. Lot No: _____ Recorded Plat: _____

5. Private Claims: _____

I, Carl T. Kiiskila, in a field survey on January, 2000 do hereby state that under requirements of PA 74, Michigan PA of 1970, the corner points mentioned in lines 1 and 2 above were in conformance with regulations and rules therefore as required in the current manual of survey instructions of the United States Department of the Interior, Bureau of Land Management or by a decree of a Court of Law and/or that the corner points mentioned in lines 3, 4 and 5 above were in conformance with the rules of the Michigan Board of Land Surveyors or by a Decree of a Court of Law; established, re-established, monumented, recovered, found as expressed below:

NOTE: Not more than 2 corners, all in the same town and range, may be recorded on this certificate.

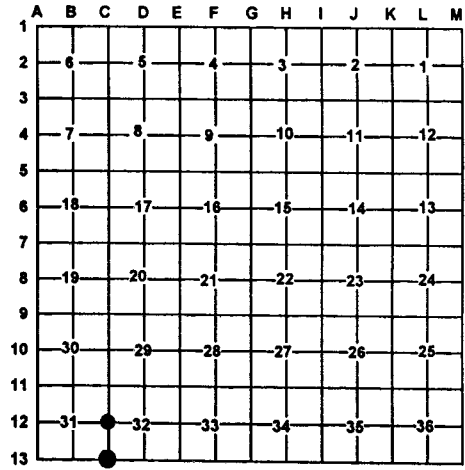

A. Description of original monument and accessories and/or subsequent restoration:

C-12 GLO – James H. Mullett D.S. 1846.
Set quarter section post
Wit: W. Pine 12 N53°W 28 links
Y. Pine 20 S87°E 25 links

C-13 GLO- Lewis Clawson D.S. 1838
Set section post corner section 31 and 32 in deep hollow, no witness within a convenient distance.

Paul B. Lapham and Associates used this corner position circa 1990 for its project -N986415. No type of monument or witnesses given.

Paul B. Lapham and Associates used this corner position circa 1990 for its project- N986415. No type of monument or witnesses given.

B. Description of corner evidence found and/or method applies in restoring or re-establishing corner:

C-12 Found a ½" rod fitting Paul B. Lapham and Associates distances in section 31.

C-13 Found a 2" iron pipe fitting Paul B. Lapham and Associates distances in section 31.



C. Description of monument for corner and accessories established to perpetuate locating the position of the corner:

C-12 Found ½" iron rod
Wit: 22" White Pine S70°E 29.93'
20" White Pine N63°E 37.16'
7" Oak S72°W 51.05'
Cedar Post N82°W 50.91'
Centerline of N-S blacktop road West 14.5'±

C-13 Found 2" iron pipe
Wit: 3" Maple S52°E 19.66'
10" Oak S34°W 37.89'
6" Oak N63°W 8.05'
3" Red Pine S12°W 28.52'
Ogemaw Co. Mon. East 13.20'

Signed by: Carl T. Kiiskila
Surveyor's Michigan License No.: 33981

Date: 8-30-01