

LAND CORNER RECORDATION CERTIFICATE
Filing Requirement of Act 74, Mich. P.A. 1970

For corners in
OGEMAW
(County)

Located In:

Corner Code ≠#

- | | | | | | |
|------------------------------------|---|------------|---|-----------|------------|
| 1. Public Land Survey | T | <u>23N</u> | R | <u>3E</u> | <u>L-6</u> |
| | T | | R | | |
| | T | | R | | |
| | T | | R | | |
| 2. Property Controlling in Section | S | <u>13</u> | T | | <u>9</u> |
| | S | <u>13</u> | T | | <u>11</u> |
| 3. Miscellaneous Property in Sec. | S | | T | | |
| | S | | T | | |

Register of Deeds Stamp & File Number

4. Lot No. _____, Recorded Plat _____
5. Private Claims _____

I, CARL R. JOHNSON, in a field survey on APRIL 11, 19 91, do hereby certify that under requirements of P.A. 74, Michigan P.A. of 1970, the corner points mentioned in lines 1 and 2 above were in conformance with regulations and rules therefore as required in the current manual of survey instructions of the United States Department of the Interior, Bureau of Land Management or by a decree of a Court of Law and/or that the corner points mentioned in lines 3, 4 and 5 above were in conformance with the rules of the Michigan Board of Land Surveyors or by a Decree of a Court of Law; established, re-established, monumented, re-monumented, recovered, found as expressed below:

NOTE: Not more than 4 corners, all in the same town and range, may be recorded on this certificate.

A. Description of original monument and accessories and/or subsequent restoration:

<u>L-6</u>	<u>9</u>	<u>11</u>
------------	----------	-----------


	A	B	C	D	E	F	G	H	I	J	K	L	M
2	6		5		4		3		2		1		
3													
4	7		8		9		10		11		12		
5													
6	18		17		16		15		14		13		
7													
8	19		20		21		22		23		24		
9													
10	30		29		28		27		26		25		
11													
12	31		32		33		34		35		36		
13													

B. Description of corner evidence found and/or method applied in restoring or reestablishing corner:

<u>L-6</u>	<u>9</u>	<u>11</u>
SET AT COMPUTED INTERSECTION OF 1/4 LINES.	SET BY STANDARD SURVEY PROCEDURE FOR SUBDIVISION OF A SECTION.	SET BY STANDARD SURVEY PROCEDURE FOR SUBDIVISION OF A SECTION.

C. Description of monument for corner and accessories established to perpetuate locating the position of the corner:

<u>L-6</u>	<u>9</u>	<u>11</u>
CENTER OF SEC. 13 DNR MON.	E 1/8 COR. ON E-W 1/4 LINE S. 13 5/8" BAR W/CAP	CENTER OF SW 1/4 SEC. 13 5/8" BAR W/CAP
DAK 48" S60W 118.5 FT.	W. PINE 8" N72W 58.7 FT.	MAPLE 12" N50E 16.05 FT.
CHERRY 10" N61E 79.3 FT.	MAPLE 6" S45N 38.4 FT.	W. PINE 5" S22E 20.2 FT.
DAK 10" N31E 91.7 FT.	MAPLE 8" N41E 8.2 FT.	W. PINE 4" N87W 27.2 FT.
	MAPLE 10" S30E 17.8 FT.	W. PINE 6" N56W 38.85 FT.

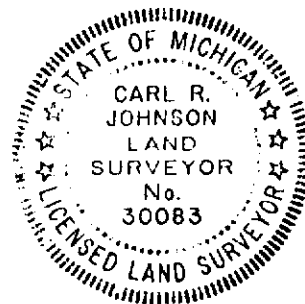

Signed by Carl R. Johnson Date 3/17/92
 Surveyor's Michigan License No. 30083