LAND CORNER RECORDATION CERTIFICATE
Filing Requirement of Act 74, Mich. P.A. 1970

For corners in
OGEMAW
(County)

	Located In:	Corner Code ##
1. Public Land Survey	T 23N R 3E	K-6
	T ___ R ___	
	T ___ R ___	
	T ___ R ___	
2. Property Controlling	S 13 T ___ R ___	7
in Section	S 13 T ___ R ___	6
3. Miscellaneous	S ___ T ___ R ___	
Property in Sec.	S ___ T ___ R ___	

Register of Deeds Stamp & File Number

4. Lot No. _____ , Recorded Plat _____
5. Private Claims _____

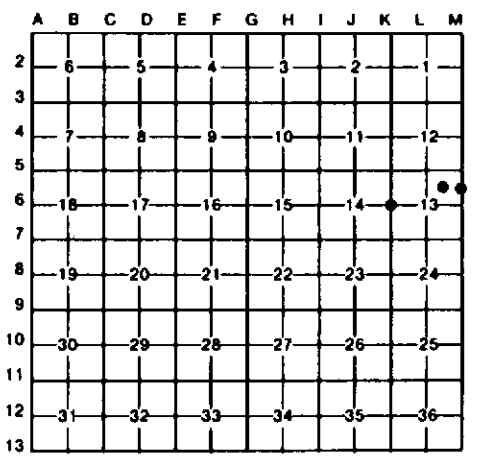

I, CARL R. JOHNSON, in a field survey on APRIL 10, 19 91, do hereby certify that under requirements of P.A. 74, Michigan P.A. of 1970, the corner points mentioned in lines 1 and 2 above were in conformance with regulations and rules therefore as required in the current manual of survey instructions of the United States Department of the Interior, Bureau of Land Management or by a decree of a Court of Law and/or that the corner points mentioned in lines 3, 4 and 5 above were in conformance with the rules of the Michigan Board of Land Surveyors or by a Decree of a Court of Law; established, re-established, monumented, re-monumented, recovered, found as expressed below:

NOTE: Not more than 4 corners, all in the same town and range, may be recorded on this certificate.

A. Description of original monument and accessories and/or subsequent restoration:

K-6	7	6

B. Description of corner evidence found and/or method applied in restoring or reestablishing corner:

K-6	7	6
SET MIDWAY AND ON LINE BETWEEN SECTION CORNERS	SET BY STANDARD SURVEY PROCEDURE FOR SUBDIVISION OF A SECTION	SET BY STANDARD SURVEY PROCEDURE FOR SUBDIVISION OF A SECTION.

C. Description of monument for corner and accessories established to perpetuate locating the position of the corner:

K-6	7	6
N1/4 COR. SEC. 13	N1/8 COR. ON E. LINE SEC. 13	CENTER OF NE1/4 SEC. 13
DNR MON.	5/8" BAR W/CAP	5/8" BAR W/CAP
W. BIRCH 5" N66W 6.1 FT.	W. PINE 22" N76E 43.02 FT.	BALSAM 8" S54E 37.0 FT.
OAK 18" N55E 61.9 FT.	W. PINE 18" S63E 37.23 FT.	MAPLE 6" N43E 65.5 FT.
CLUMP MAPLE 6" S54E, 75.8 FT.	TWIN BIRCH 10" N71W 33.73 FT.	IRONWOOD 10" N44W 53.5 FT.
	ASPEN 6" S46W 28.03 FT.	W. PINE 6" N81W 50.8 FT.
	DNR SIGN POST N38W 48.7 FT.	

STATE OF MICHIGAN
CARL R. JOHNSON
LAND SURVEYOR
No. 30083
LICENSED LAND SURVEYOR

Signed by Carl R. Johnson Date 3/17/92

Surveyor's Michigan License No. 30083

FORM APPROVED BY MICHIGAN STATE BOARD OF LAND SURVEYORS, JAN. 28, 1971
REVISED MAY 14, 1975
REVISED JAN., 1983