

LAND CORNER RECORDATION CERTIFICATE
Filing Requirement of Act 74, Mich. P.A. 1970

For corners in

| | | |
|---------------------------------------|--------------------------------------|---------------------------|
| <u>Ogemaw</u> (County) | Located In: | Corner Code ## |
| 1. Public Land Survey | T <u>23N</u> R <u>3E</u> | <u>J-11</u> |
| | T <u>23N</u> R <u>3E</u> | <u>I-10</u> |
| | T _____ R _____ | _____ |
| | T _____ R _____ | _____ |
| | T _____ R _____ | _____ |
| 2. Property Controlling in Section | S <u>26</u> T <u>23N</u> R <u>3E</u> | <u>4</u> |
| | S <u>26</u> T <u>23N</u> R <u>3E</u> | <u>8</u> |
| 3. Miscellaneous Property in Sec. | S _____ T _____ R _____ | _____ |
| | S _____ T _____ R _____ | _____ |

Register of Deeds Stamp & File Number

4. Lot No. _____, Recorded Plat _____
 5. Private Claims _____

I, Carl R. Johnson, in a field survey on May 19, 19 87, do hereby certify that under requirements of P.A. 74, Michigan P.A. of 1970, the corner points mentioned in lines 1 and 2 above were in conformance with regulations and rules therefore as required in the current manual of survey instructions of the United States Department of the Interior, Bureau of Land Management or by a decree of a Court of Law and/or that the corner points mentioned in lines 3, 4 and 5 above were in conformance with the rules of the Michigan Board of Land Surveyors or by a Decree of a Court of Law; established, re-established, monumented, re-monumented, recovered, found as expressed below:

NOTE: Not more than 4 corners, all in the same town and range, may be recorded on this certificate.

| | | | | | | | | | | | | | |
|----|----|----|----|----|----|----|---|---|---|---|---|---|---|
| | A | B | C | D | E | F | G | H | I | J | K | L | M |
| 2 | 6 | 5 | 4 | 3 | 2 | 1 | | | | | | | |
| 3 | | | | | | | | | | | | | |
| 4 | 7 | 8 | 9 | 10 | 11 | 12 | | | | | | | |
| 5 | | | | | | | | | | | | | |
| 6 | 18 | 17 | 16 | 15 | 14 | 13 | | | | | | | |
| 7 | | | | | | | | | | | | | |
| 8 | 19 | 20 | 21 | 22 | 23 | 24 | | | | | | | |
| 9 | | | | | | | | | | | | | |
| 10 | 30 | 29 | 28 | 27 | 26 | 25 | | | | | | | |
| 11 | | | | | | | | | | | | | |
| 12 | 31 | 32 | 33 | 34 | 35 | 36 | | | | | | | |
| 13 | | | | | | | | | | | | | |

A. Description of original monument and accessories and/or subsequent restoration:

B. Description of corner evidence found and/or method applied in restoring or reestablishing corner:

- J-11 - Set in line with old fence lines north and south, and midway between R/W fences along County Road. No other evidence of corner restoration.
 I-10 - Found 1/2" bar in place as established in a previous survey of Section 27 by Granger Engineering.
 4 - Set by standard survey procedure for subdivision of a section.
 8 - Set by standard survey procedure for subdivision of a section.

C. Description of monument for corner and accessories established to perpetuate locating the position of the corner:


J-11 - S-1/4 Corner
 DNR Mon. - pipe is 1.6' long
 White Pine 10" N62°E 48.83' nail & dnr ref. mkr.
 White Pine 8" S63°E 60.89' nail & DNR ref. mkr.
 Jack Pine 6" S57°W 52.26' nail & DNR Ref. mkr.
 Cedar post due north 12.0'
 Cor. is 6.0' North of E of E-W road.

I-10 - W 1/4 corner
 DNR mon. - pipe is 1.6' long
 B. Ash 3" S48°E 14.30' JLS-26466 ref. mk
 Double Elm Stp. S80°W 37.09' JLS-26466 ref. mkr.
 Red Oak 12" N9°E 87.85' JLS-26466 ref. mk
 Cedar Post due east 12.0'

4 - Center of the NW 1/4
 5/8" bar w/cap & cedar post
 Cedar 8" N44°W 24.1'
 Cedar 5" N55°E 7.1'
 Cedar 5" S64°E 13.7'
 Cedar 8" S53°W 5.0'

8 - W 1/8 Cor. on E-W 1/4 Line
 5/8" bar w/cap & cedar post
 Balsam 5" N55°E 29.0'
 Balsam 6" S78°E 23.3'
 Balsam 5" N62°W 8.8'

Signed by Carl R. Johnson
 Surveyor's Michigan License No. 30083

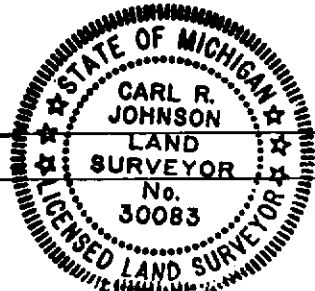

Date 1/4/88