

**SURVEY &
REMONUMENTATION**

MAY 03 1995

LAND CORNER RECORDATION CERTIFICATE

COMMISSION Filing Requirement of Act 74, Mich. P.A. 1970

For corners in
OGEMAW
(County)

Located In: _____ Corner Code J-1

LIBER

2 PAGE **259**

STATE OF MICHIGAN
OGEMAW COUNTY
RECORDED

3 JAN 95 9:35 A.M.

WANDA MUZIK
REGISTER OF DEEDS
Register of Deeds Stamp & File Number

- | | | |
|---------------------------------------|--------------------------|------------|
| 1. Public Land Survey | T <u>23N</u> R <u>3E</u> | <u>J-1</u> |
| | T _____ R _____ | _____ |
| | T _____ R _____ | _____ |
| | T _____ R _____ | _____ |
| 2. Property Controlling
in Section | S _____ T _____ R _____ | _____ |
| | S _____ T _____ R _____ | _____ |
| 3. Miscellaneous
Property in Sec. | S _____ T _____ R _____ | _____ |
| | S _____ T _____ R _____ | _____ |
| 4. Lot No. _____, Recorded Plat _____ | | |
| 5. Private Claims _____ | | |

A	B	C	D	E	F	G	H	I	J	K
2	6	5	4	3	2					
3										
4	7	8	9	10	11					
5										
6	18	17	16	15	14					
7										
8	19	20	21	22	23					
9										
10	30	29	28	27	26					
11										
12	31	32	33	34	35					
13										

I, Timothy L. Lapham, in a field survey on December, 19 94, do hereby certify that under requirements of P.A. 74, Michigan P.A. of 1970, the corner points mentioned in lines 1 and 2 above were in conformance with regulations and rules therefore as required in the current manual of survey instructions of the United States Department of the Interior, Bureau of Land Management or by a decree of a Court of Law and/or that the corner points mentioned in lines 3, 4 and 5 above were in conformance with the rules of the Michigan Board of Land Surveyors or by a Decree of a Court of Law; established, re-established, monumented, re-monumented, recovered, found as expressed below:

NOTE: Not more than 4 corners, all in the same town and range, may be recorded on this certificate.

A. Description of original monument and accessories and/or subsequent restoration:
J-1: NOT SET BY GLO

1945 SHADKO (DNR) SURVEY, IN THIS SURVEY IT WAS ASSUMED THAT THE CORNER WAS COMMON WITH J13 T24 NR3E, FOUND STAKE SET MONUMENT, 4 WITNESSES
NO RECORDED SURVEYS
NO RECORDED LCRC

B. Description of corner evidence found and/or method applied in restoring or reestablishing corner:


J-1: SET CORNER MIDWAY BETWEEN RECORDED CORNERS I-1 AND K-1 ON TOWNSHIP LINE 14.04' EAST OF ESTABLISHED CORNER J-13 T24N R3E (J-13 IS SHADKO CORNER)
ACCEPTED ESTABLISHED POSITION AS BEST AVAILABLE EVIDENCE OF THE CORRECT POSITON OF THE ORIGINAL CORNER

CORNER APPROVED AT PEER REVIEW MEETING HELD DECEMBER 21, 1994
SEE DOSSIER FOR ADDITIONAL INFORMATION

APPROVED BY PEER REVIEW	
12-21-94	<i>ML</i>
DATE	P.A. 345 of 1990

C. Description of monument for corner and accessories established to perpetuate locating the position of the corner:

- J-1: SET 5/8"x36" REROD WITH 3-1/4" ALUMINUM OGEMAW REMON CAP IN MON BOX
N58E 71.26' NAIL IN 10" JACK PINE
S18E 54.17' NAIL IN 6" RED PINE
S38W 48.33' NAIL IN 4" TAMARACK
WEST 14.04' REMON MONUMENT (J-13 T24N R3E)
N54W 52.22' NAIL IN 10" JACK PINE

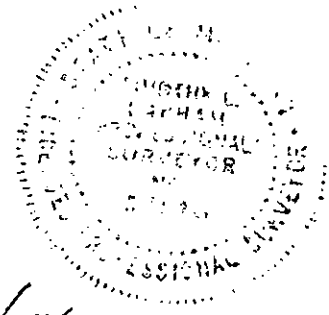

Signed by *Timothy L. Lapham*
Surveyor's Michigan License No. 27595

Date 12/29/94