SURVEY &
REMONUMENTATION

MAY 0 3 1995

COMMISSION

LAND CORNER RECORDATION CERTIFICATE

Filing Requirement of Act 74, Mich. P.A. 1970

For corners in
OGEMAW
(County)

LIBER 2 PAGE 263

STATE OF MICHIGAN
OGEMAW COUNTY
RECORDED

3 JAN 95 9:36 A.M.

WANDA MUZIK
REGISTER OF DEEDS
Register of Deeds Stamp & File Number

		Located In:	Corner Code ##
1. Public Land Survey		T 23N R 3E	M-3
		T ___ R ___	
		T ___ R ___	
		T ___ R ___	Deg. #1
2. Property Controlling	S ___	T ___ R ___	
in Section	S ___	T ___ R ___	
3. Miscellaneous	S ___	T ___ R ___	
Property in Sec.	S ___	T ___ R ___	

4. Lot No. _____, Recorded Plat _____
5. Private Claims _____

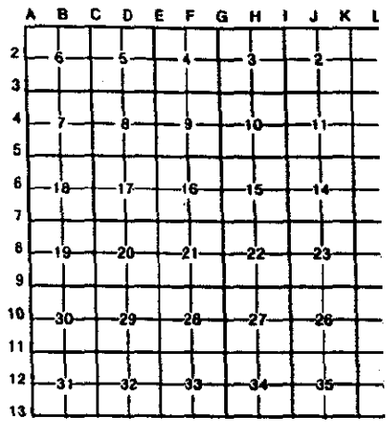

I, Timothy L. Lapham, in a field survey on December, 19 94, do hereby certify that under requirements of P.A. 74, Michigan P.A. of 1970, the corner points mentioned in lines 1 and 2 above were in conformance with regulations and rules therefore as required in the current manual of survey instructions of the United States Department of the Interior, Bureau of Land Management or by a decree of a Court of Law and/or that the corner points mentioned in lines 3, 4 and 5 above were in conformance with the rules of the Michigan Board of Land Surveyors or by a Decree of a Court of Law; established, re-established, monumented, re-monumented, recovered, found as expressed below:

NOTE: Not more than 4 corners, all in the same town and range, may be recorded on this certificate.

A. Description of original monument and accessories and/or subsequent restoration:
M-3: GLO CLASON 1838, SET POST
HEMLOCK 12" S40W 21LKS
W. PINE 10" N67W 49LKS

B. Description of corner evidence found and/or method applied in restoring or reestablishing corner:
M-3: FOUND 1-1/4" IRON PIPE AND PIECE OF OLD CEDAR STAKE NEAR ANCIENT FENCE CORNER
DISTANCE NORTH AND SOUTH AGREE WITH GLO
ACCEPTED FOUND IRON AS BEST AVAILABLE EVIDENCE OF THE POSITION OF THE ORIGINAL CORNER

CORNER APPROVED AT PEER REVIEW MEETING HELD ON DECEMBER 21, 1994
SEE DOSSIER FOR ADDITIONAL INFORMATION

APPROVED BY
PEER REVIEW
12-21-94 [illegible]
DATE P.A. 345 of 1990

C. Description of monument for corner and accessories established to perpetuate locating the position of the corner:
M-3: SET 5/8"x36" REROD WITH 3-1/4" ALUMINUM OGEMAW REMON CAP
N24E 14.15' NAIL IN 4" ASH
S71E 44.26' NAIL IN 8" YELLOW POPLAR
S05E 8.80' NAIL IN 10" YELLOW POPLAR
N66W 31.88' NAIL IN 10" YELLOW POLAR

Signed by [signature] Date 12/29/94

Surveyor's Michigan License No. 27595

FORM APPROVED BY MICHIGAN STATE BOARD OF LAND SURVEYORS, JAN. 28,
REVISED MAY 14,
REVISED JAN.