SURVEY &
REMONUMENTATION

MAY 0 3 1995

COMMISSION

LAND CORNER RECORDATION CERTIFICATE

Filing Requirement of Act 74, Mich. P.A. 1970

For corners in OGEMAW (County)

LIBER 2 PAGE 249
STATE OF MICHIGAN
OGEMAW COUNTY
RECORDED

3 JAN 95 9:31 A.M.

WANDA MUZIK
REGISTER OF DEEDS
Register of Deeds Stamp & File Number

	Located In:	Corner Code ##
1. Public Land Survey	T 23N R 3E	M-6
	T ___ R ___	
	T ___ R ___	
	T ___ R ___	
2. Property Controlling	S ___ T ___ R ___	Seg. #1
in Section	S ___ T ___ R ___	
3. Miscellaneous	S ___ T ___ R ___	
Property in Sec.	S ___ T ___ R ___	

4. Lot No. _____, Recorded Plat _____
5. Private Claims _____

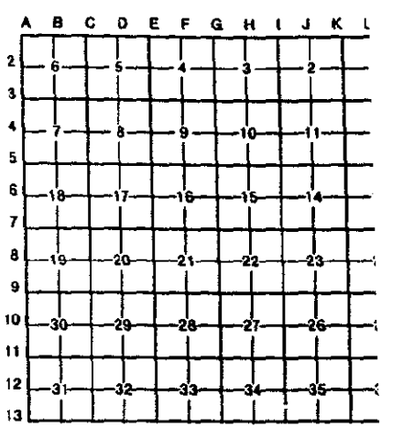

I, Timothy L. Lapham, in a field survey on December, 19 94, do hereby certify that under requirements of P.A. 74, Michigan P.A. of 1970, the corner points mentioned in lines 1 and 2 above were in conformance with regulations and rules therefore as required in the current manual of survey instructions of the United States Department of the Interior, Bureau of Land Management or by a decree of a Court of Law and/or that the corner points mentioned in lines 3, 4 and 5 above were in conformance with the rules of the Michigan Board of Land Surveyors or by a Decree of a Court of Law; established, re-established, monumented, re-monumented, recovered, found as expressed below:

NOTE: Not more than 4 corners, all in the same town and range, may be recorded on this certificate.

A. Description of original monument and accessories and/or subsequent restoration:
M-6: CLASON 1838, SET POST, BEECH 10" S60W 18L., BEECH 14" N40W 50L.
HIGGINS 6/03/1977, SURVEY #77052 UNRECORDED, FD 3/4" IRON, 3 WITNESSES
KING 10/30/1986, SURVEY 4-68, FOUND IRON AND CAP #12018, 4 WITNESSES
KING 9/09/1991, SURVEY 5-428, REVISION OF 4-68, NO CORNER CHANGE

B. Description of corner evidence found and/or method applied in restoring or reestablishing corner:
M-6: FOUND 1/2" IRON AND CAP, WITNESSES MATCH 1977 AND 1986 SURVEYS
GLO SWAMP CALL NORTH AT 4 CH.(264') MEASURES 220'+/- THIS CONSIDERED ACCEPTABLE, CORNER ACCEPTED AS BEST AVAILABLE EVIDENCE OF ORIGINAL CORNER POSITION, CORNER APPROVED AT PEER REVIEW MEETING HELD ON DECEMBER 21,1994
SEE REMONUMENTATION DOSSIER FOR ADDITIONAL INFORMATION.

APPROVED BY
PEER REVIEW
12-21-94
DATE P.A. 345 of 1990

C. Description of monument for corner and accessories established to perpetuate locating the position of the corner:
M-6: SET 5/8"x36" REROD WITH 3-1/4" ALUMINUM REMON CAP
S86E 33.10 CAPPED IRON #21570
S15E 97.05 FOUND NAIL IN 24" RED PINE
S84W 27.47 SET NAIL IN GATE POST
N41E 52.32 SET NAIL IN 10" WHITE PINE

MICHIGAN
TIMOTHY L. LAPHAM
PROFESSIONAL SURVEYOR
NO. 27595

Signed by _____ Date 12/29/94

Surveyor's Michigan License No. 27595

FORM APPROVED BY MICHIGAN STATE BOARD OF LAND SURVEYORS, JAN. 28. REVISED MAY 14.